


STATE OF KANSAS
STATE CORPORATION COMMISSION

Form CP-4

Give All Information Completely
Make Required Affidavit
Mail or Deliver Report to:
Conservation Division
State Corporation Commission
212 No. Market
Wichita, Kansas 67202

WELL PLUGGING RECORD

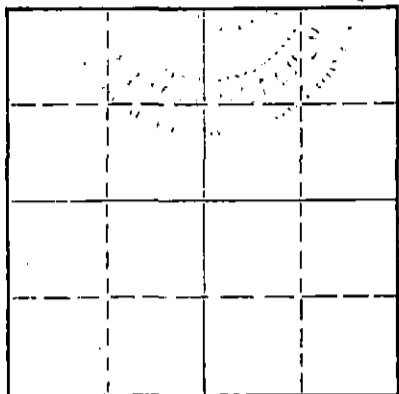

Locate well correctly on above
Section Plat

Pratt County, Sec. 22 Twp. 28 Rge. 12 (E) (W)
Location as "NE/CNW/SW" or footage from lines C SW NE SE
Lease Owner Raymond Oil Co., Inc.
Lease Name Chitwood G#5 Well No.
Office Address Wichita, Kansas 67206
Character of Well (completed as Oil, Gas or Dry Hole)
Date well completed 19____
Application for plugging filed 19____
Application for plugging approved 19____
Plugging commenced 2/17/70 19____
Plugging completed 2/24/70 19____
Reason for abandonment of well or producing formation depleted.
If a producing well is abandoned, date of last production 19____
Was permission obtained from the Conservation Division or its agents before plugging was commenced? YES

Name of Conservation Agent who supervised plugging of this well Biberstein
Producing formation _____ Depth to top _____ Bottom _____ Total Depth of Well 4421 Feet
Show depth and thickness of all water, oil and gas formations.

OIL, GAS OR WATER RECORDS

CASING RECORD

FORMATION	CONTENT	FROM	TO	SIZE	PUT IN	PULLED OUT
				8-5/8	344	none
				5 1/2"	4455'	3218'

RECEIVED
STATE CORPORATION COMMISSION
MAR 3 1970
CONSERVATION DIVISION
Wichita, Kansas

Describe in detail the manner in which the well was plugged, indicating where the mud fluid was placed and the method or methods used in introducing it into the hole. If cement or other plugs were used, state the character of same and depth placed, from _____ feet to _____ feet for each plug set.

Checked hole to 4421' and ran sand to 4375', set 5 sacks of cement.
Loaded hole with water, shot pipe at 3208', pumped load of water, had 800 lb. pressure. Pumped 40 barrels oil and 80 barrels water.
Worked pipe loose and pulled 103 joints. Bailed hole to 250', set 10' rock bridge and ran 25 sacks of cement. Mudded hole to 40', set 10' rock bridge and ran 10 sacks of cement.

PLUGGING COMPLETE.

(If additional description is necessary, use BACK of this sheet)
Name of Plugging Contractor KNIGHT CASING PULLING CO., INC.
Address CHASE, KANSAS

STATE OF KANSAS COUNTY OF RICE, SS.
NOEL J. KNIGHT

(employee of owner) or (owner or operator) of the above-described well, being first duly sworn on oath, says: That I have knowledge of the facts, statements, and matters herein contained and the log of the above-described well as filed and that the same are true and correct. So help me God.

(Signature) Noel Knight
CHASE, KANSAS
(Address)

SUBSCRIBED AND SWORN TO before me this 25th day of February, 19 80

My commission expires 2/15/71
Margaret Ornelcher
Notary Public.

RECEIVED
 STATE CORPORATION COMMISSION
 FEB 10 1970
 CONSERVATION DIVISION
 Wichita, Kansas

K224

The Winkler-Koch Engineering Company
 Willard 3

SW NE SE
 Sec. 22, Twp. 28, Rge. 12,
 County: Pratt, Kansas

Total Depth: 4460'
 Comm: 11-14-45 Comp: 12-9-45

Casing	Cement
8 5/8" Set 344'	250 Sacks
5 1/2" Set 4460'	200 Sacks

Potential: 4392 Bbls.

Formation:	Depth:
Surface Oil & Clay	45'
Sand	100'
Sand and Red Bed	355'
Sand and Shale	520'
Red Bed	805'
Red Bed and Shale	1095'
Shale	1289'
Shale and Salt	1700'
Shale	1758'
Shale and Lime	2146'
Lime	2355'
Lime and Shale	2492'
Lime	2583'
Lime and Shale	2760'
Shale	2791'
Lime and Shale	3230'
Shale and Shells	3275'
Shale	3418'
Shale and Lime	3584'
Shale	3628'
Lime	4183'
Shale	4294'
Lime	4309'
Shale	4351'
Lime and Shale	4392'
Sand	4414'
Shale and Lime	4460'
Total Depth	4460'