

STATE OF KANSAS
STATE CORPORATION COMMISSION


Give All Information Completely
Make Required Affidavit
Mail or Deliver Report to:
Conservation Division
State Corporation Commission
212 No. Market
Wichita, Kansas

WELL PLUGGING RECORD

Pratt County, Sec. 22 Twp. 28 Rge. 12 (E) W (W)
NE SW/4 SE/4

Location as "NE/CNW/SE" or footage from lines _____
Lease Owner Raymond Oil Co., Inc.
Lease Name Chitwood #4 Well No. _____
Office Address Wichita, Kansas 67202
Character of Well (completed as Oil, Gas or Dry Hole) _____
Date well completed _____ 19____
Application for plugging filed _____ 19____
Application for plugging approved _____ 19____
Plugging commenced 11/19/69 _____ 19____
Plugging completed 11/26/69 _____ 19____
Reason for abandonment of well or producing formation depleted.
If a producing well is abandoned, date of last production _____ 19____
Was permission obtained from the Conservation Division or its agents before plugging was commenced? yes

NORTH

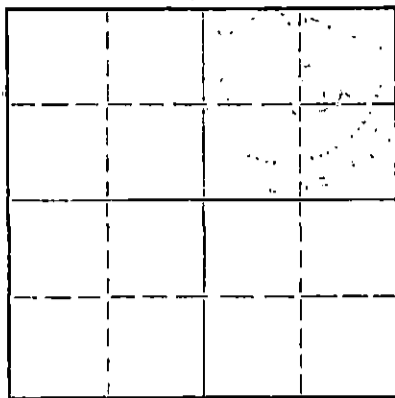

Locate well correctly on above Section Plat

Name of Conservation Agent who supervised plugging of this well Justice
Producing formation _____ Depth to top _____ Bottom _____ Total Depth of Well 4502 Feet
Show depth and thickness of all water, oil and gas formations.

OIL, GAS OR WATER RECORDS

CASING RECORD

FORMATION	CONTENT	FROM	TO	SIZE	PUT IN	PULLED OUT
				8-5/8	308	none
				5 1/2"	4499	1774

Describe in detail the manner in which the well was plugged, indicating where the mud fluid was placed and the method or methods used in introducing it into the hole. If cement or other plugs were used, state the character of same and depth placed, from _____ feet to _____ feet for each plug set.

Checked hole to 4502', ran sand to 4375' and ran 5 sacks of cement.
Shot pipe at 3188', worked pipe, parted pipe at 23 joints, pulled pipe.
Got overshot and ran pipe in hole 21 joints, pumped pipe down, checked hole to 832', mud came in, ran tools in hole to 832', couldn't knock bridge out, pumped hole, ran tubing 40 joints in hole, pumped hole, pulled tubing, shot pipe at 2488', 1988', 1800', pulled pipe.
Bailed hole to 250', set 10' rock bridge and ran 25 sacks of cement.
Mudded hole to 40', set 10' rock bridge and ran 10 sacks of cement.
Tallied pipe.

PLUGGING COMPLETE.

Handwritten: Done 11/26/69

(If additional description is necessary, use BACK of this sheet)
Name of Plugging Contractor KNIGHT CASING PULLING CO., INC.
Address CHASE, KANSAS


STATE OF KANSAS COUNTY OF RICE, ss.
NOEL J. KNIGHT (employee of owner) or (owner or operator) of the above-described

well, being first duly sworn on oath, says: That I have knowledge of the facts, statements, and matters herein contained and the log of the above-described well as filed and that the same are true and correct. So help me God.

(Signature) Noel Knight
CHASE, KANSAS
(Address)

Subscribed AND SWORN TO before me this 28th day of November, 19 69

Margaret Melcher
Notary Public.

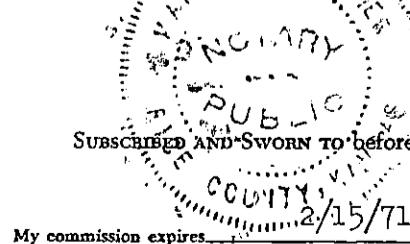

My commission expires _____

Lion Oil Refining Company
El Dorado, Arkansas

Mawdsley Well No. 2

NE Corner SW/4, SE/4
Sec. 22-28-12, Pratt
County, Kansas

Contractor: R. W. Mine Drilling Company
Commenced: February 20, 1944

Completed: March 29, 1944

	LOG	
Clay	0-100	
Sand & Shale	100-200	
Shale & Shells	200-308	8 5/8" casing cemented @ 303'
Red Bed	308-824	
Shale & Shells	824-1815	
Lime	1815-1850	
Lime & Shale	1850-2325	
Shale	2325-2445	
Shale & Lime	2445-2565	
Shale	2565-2820	
Shale & Lime	2820-3165	
Shale	3165-3275	
Shale & Lime	3275-3285	
Shale	3285-3333	
Lime	3333-4098	
Shale & Lime	4098-4143	
Lime & Chert	4143-4185	
Shale & Lime	4185-4226	
Shale	4226-4291	
Lime	4291-4329	
Shale & Chert	4329-4350	
Lime & Shale	4350-4376	
Lime	4376-4388	
Sand	4388-4419	
Sand & Shale	4419-4428	
Shale	4428-4476	
Lime	4476-4478	
Shale & Lime	4478-4493	
Arbuckle Lime	4493-4495	5 1/2" Casing cemented @ 4492' Total Depth 4495'

RECEIVED
STATE CORPORATION COMMISSION
NOV 12 1969
CONSERVATION DIVISION
Wichita, Kansas

State of Kansas)
County of Barton) ss.

I, Clyde W. Goddard, do hereby certify that the above is a true and complete log of the Mawdsley Well No. 2, located in the NE Corner of the SW/4 of the SE/4 of Section 22, Township 28, Range 12, in Pratt County, Kansas.

Clyde W. Goddard

Sworn to and subscribed before me this 1 day of April, 1944.

Ralph M. Muesel

My commission expires 1-8-45.