


STATE OF KANSAS
STATE CORPORATION COMMISSION

Form CP-4

Give All Information Completely
Make Required Affidavit
Mail or Deliver Report to:
Conservation Division
State Corporation Commission
212 No. Market
Wichita, Kansas

WELL PLUGGING RECORD

NORTH

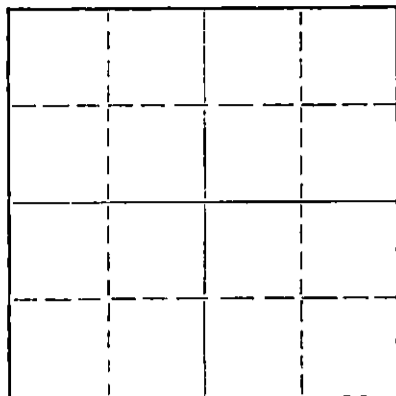

Locate well correctly on above
Section Plat

Pratt County, Sec. 22 Twp. 28S Rge. 12 (E) W (W)
Location as "NE/CNW/SW" or footage from lines NE SW SW
Lease Owner Raymond Oil Co.
Lease Name Chitwood Unit, Well No. F-1
Office Address Wichita, Kans.
Character of Well (completed as Oil, Gas or Dry Hole)
Date well completed 19
Application for plugging filed 19
Application for plugging approved 19
Plugging commenced Dec. 16 1969
Plugging completed Dec. 19 1969
Reason for abandonment of well or producing formation

If a producing well is abandoned, date of last production 19
Was permission obtained from the Conservation Division or its agents before plugging was commenced? Yes

Name of Conservation Agent who supervised plugging of this well Herman Justice
Producing formation Depth to top Bottom Total Depth of Well Feet
Show depth and thickness of all water, oil and gas formations.

OIL, GAS OR WATER RECORDS

CASING RECORD

FORMATION	CONTENT	FROM	TO	SIZE	PUT IN	PULLED OUT

Describe in detail the manner in which the well was plugged, indicating where the mud fluid was placed and the method or methods used in introducing it into the hole. If cement or other plugs were used, state the character of same and depth placed, from feet to feet for each plug set.

Sanded back to 3400' and dumped 5 sacks of cement. Shot pipe off at 762'. Pulled pipe and mudded hole to 210'. Set 10' rock bridge and dumped 35 sacks of cement. Finished mudding hole and dumped 15 sacks of cement at top of cellar.

RECEIVED
STATE CORPORATION COMMISSION
JAN 22 1970
CONSERVATION DIVISION
Wichita, Kansas
1-22-70

Name of Plugging Contractor Bert Self
Address Hutchinson, Kans.

STATE OF Kans., COUNTY OF Reno, ss.
Employee (employee of owner) or (owner or operator) of the above-described well, being first duly sworn on oath, says: That I have knowledge of the facts, statements, and matters herein contained and the log of the above-described well as filed and that the same are true and correct. So help me God.

(Signature) Bert Self
R. R. #4, Hutchinson, Kans.
(Address)

Subscribed and Sworn to before me this 16th day of January, 1970



October 18, 1973 Notary Public.