


WELL PLUGGING RECORD

15-129-20731-0003

Give All Information Completely  
 Make Required Affidavit

COUNTY Morton SEC. 13 TWP. 31S RGE. 41 E/W  
 Location as in quarters or footage from lines:  
950' FSL & 330' FWL

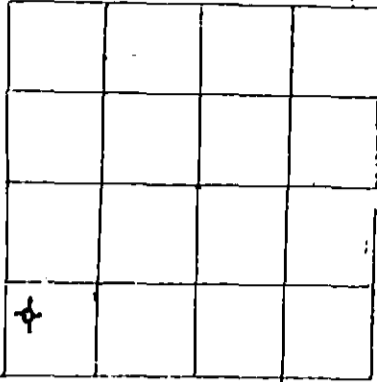

Locate Well  
 correctly on above.  
 Section Platt.

Lease Owner J. M. Huber Corporation  
 Lease Name Martha Barnhardt Well No. 13-1  
 Office Address 7120 I-40 West, Amarillo, TX 79106  
 Character of Well (Completed as Oil, Gas or Dry Hole): Dry hole  
 Date Well Completed 12-15-84  
 Application for plugging filed 12-13-84 (verbal w/Paul Luthe)  
 Plugging commenced 12-15-84  
 Plugging completed 12-15-84  
 Reason for abandonment of well or producing formation Dry hole

Was permission obtained from the Conservation Division or it's  
 Agent's before plugging was commenced? Yes (CL)

Name of Conservation Agent who supervised plugging of this well Paul Luthe  
 Producing formation None Depth to top \_\_\_\_\_ bottom \_\_\_\_\_ T.D. 5710'

Show depth and thickness of all water, oil and gas formations.

OIL, GAS OR WATER RECORDS

Casing Record

Formation	Content	From	To	Size	Put in	Pulled Out
				8-5/8"	1587'	None

Describe in detail the manner in which the well was plugged, indicating where the mud fluid was placed and the method or methods used in introducing it into the hold. If cement or other plugs were used, state the character of same and depth placed, from \_\_\_\_\_ feet to \_\_\_\_\_ feet for each plug set.

TIH w/DP open-ended; spot 50 sx Class H plug 5243-5123' to test against. Plugged well w/125 sx 60/40/2 Pozmix w/3% CaCl<sub>2</sub> as follows:

TIH w/DP open-ended - 1st plug 50 sx @ 1630-1530'  
 2nd plug 50 sx @ 840-740'  
 3rd plug 10 sx @ 40-0' (w/rubber plug & Cs hulls)  
 15 sx rat hole

(If additional description is necessary, use BACK of this sheet)

Name of Plugging Contractor Zenith Drilling Corporation

STATE OF Texas COUNTY OF Potter, ss.  
William D. Siddens (employee of owner) or (~~owner or operator~~) of the above-described well, being first duly sworn on oath, says: That I have knowledge of the facts, statements, and matters herein contained and the log of the above-described well as filed and that the same are true and correct. So help me God.

(Signature) William D. Siddens  
 7120 I-40 West, Amarillo, TX 79106  
 (Address)

SUBSCRIBED AND SWORN TO before me this 18 day of December, 1984

Roger Oakes  
 Notary Public

My Commission expires: 6-15-85

