


Give All Information Completely  
Make Required Affidavit  
Mail or Deliver Report to:  
Conservation Division  
State Corporation Commission  
211 No. Broadway  
Wichita, Kansas

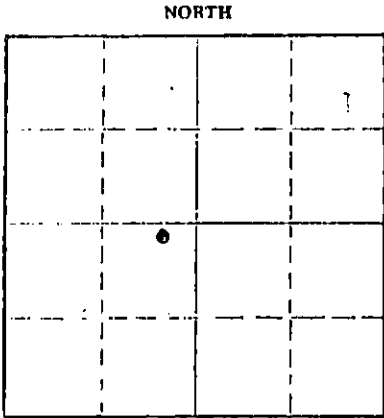

Locate well correctly on above Section Plat

County. Sec. 16 Twp. 31S Rge. 41 (W) KK  
Location as "NE/CNW/SW" or footage from lines NE NE SW  
Lease Owner Pan American Petroleum Corporation  
Lease Name Murphy Gas Unit "B" Well No. 1  
Office Address P. O. Box 432, Liberal, Kansas  
Character of Well (completed as Oil, Gas or Dry Hole) \_\_\_\_\_  
Date well completed \_\_\_\_\_ 2-19 1957  
Application for plugging filed \_\_\_\_\_ 2-16 1965  
Application for plugging approved \_\_\_\_\_ 2-17 1965  
Plugging commenced \_\_\_\_\_ 4-2 1965  
Plugging completed \_\_\_\_\_ 4-6 1965  
Reason for abandonment of well or producing formation \_\_\_\_\_  
Economically depleted  
If a producing well is abandoned, date of last production January 1964  
Was permission obtained from the Conservation Division or its agents before plugging was commenced? Yes

Name of Conservation Agent who supervised plugging of this well Hugh Scott  
Producing formation Morrow Depth to top 5363 Bottom 5397 Total Depth of Well 5481 Feet  
Show depth and thickness of all water, oil and gas formations.

OIL, GAS OR WATER RECORDS

CASING RECORD

FORMATION	CONTENT	FROM	TO	SIZE	PUT IN	PULLED OUT
Morrow	Gas	5363	5397	8-5/8	1498	None
	Depleted			5-1/2	5448	2184

Describe in detail the manner in which the well was plugged, indicating where the mud fluid was placed and the method or methods used in introducing it into the hole. If cement or other plugs were used, state the character of same and depth placed, from \_\_\_\_\_ feet to \_\_\_\_\_ feet for each plug set.

Spotted 20 sx cement plug at 5237', 35 sx cement from 700' to 600' and 15 sx cement from 45' to surface.

RECEIVED  
STATE CORPORATION COMMISSION

APR 13 1965

CONSERVATION DIVISION  
Wichita, Kansas

(If additional description is necessary, use BACK of this sheet)

Name of Plugging Contractor Sargents Casing Pulling Service  
Address Liberal, Kansas

STATE OF Kansas, COUNTY OF Seward, ss.

I, D. M. Liles (employee of owner) or (owner or operator) of the above-described well, being first duly sworn on oath, says: That I have knowledge of the facts, statements, and matters herein contained and the log of the above-described well as filed and that the same are true and correct. So help me God.

(Signature) [Signature]

P. O. Box 432, Liberal, Kansas  
(Address)

SUBSCRIBED AND SWORN to before me this 12 day of April, 1965

[Signature]  
Notary Public.

STANOLIND OIL AND GAS COMPANY

WELL RECORD

15-129-00039-0000

Murphy Gas Unit "B"

SUPPLEMENTAL (ENTER "X" WHEN APPLICABLE)

Grid for well location mapping

LOCATE WELL CORRECTLY

LEASE: ... WELL NO. 1

LOCATION OF WELL: 330 FT. NORTH SOUTH OF THE 330 FT.

EAST WEST OF THE EAST WEST LINE OF THE 1/4 1/4 1/4

OF SECTION 16 TOWNSHIP 31 NORTH SOUTH RANGE 41 EAST WEST

Horton Kansas

COUNTY STATE

ELEVATION: O.L. 3398 I.P. 3405 H.P.D. 3407

COMPLETED AS: OIL WELL GAS WELL WATER WELL DRY HOLE

DRILLING: COMMENCED 12-21-56 COMPLETED 2-14-57

OPERATING COMPANY: Pan American Petroleum Corporation ADDRESS: Box 991, Tulsa, Oklahoma

OIL OR GAS SANDS OR ZONES

Table with columns: NAME, FROM, TO, NAME, FROM, TO. Rows include Herington, Vinfield, Topoka, Lansing, Missouri, Des Moines, Kansas, Mississippi.

WATER SANDS

Table with columns: NAME, FROM, TO, WATER LEVEL, NAME, FROM, TO, WATER LEVEL. Rows include Sand, Sand.

CASING RECORD (OVERALL MEASUREMENT)

LINER-SCREEN RECORD

Table with columns: CSG. SIZE, WEIGHT, THREDS, MAKE - GRADE, QUANTITY FEET, SIZE, QUANTITY FEET, SET AT (TOP, BOTTOM), MAKE AND TYPE.

PACKER RECORD

Table with columns: SIZE, LENGTH, SET AT, MAKE AND TYPE.

CEMENTING RECORD

MUDDING RECORD

Table with columns: SIZE, WHERE SET (FEET), SACKS, CEMENT (BRAND, TYPE), METHOD, FINAL PRESS, (CABLE TOOLS) (METHOD, RESULTS).

WHAT METHOD WAS USED TO PROTECT SANDS WHEN OUTER STRINGS WERE PULLED?

RECEIVED STATE CORPORATION COMMISSION APR 13 1965 CONSERVATION DIVISION Wichita, Kansas

IF SO, STATE KIND, DEPTH SET, AND RESULTS OBTAINED

ROTARY TOOLS WERE USED FROM ... FEET TO ... FEET, AND FROM ... FEET TO ... FEET

CABLE TOOLS WERE USED FROM ... FEET TO ... FEET, AND FROM ... FEET TO ... FEET

24-HOUR PRODUCTION OR POTENTIAL TEST

20 in. Open Flow ... WATER ... BBLS.

IF GAS WELL, CUBIC FEET PER 24 HOURS ... SHUT-IN PRESSURE ... LBS. PER SQUARE IN.

I, THE UNDERSIGNED, BEING FIRST DULY SWORN UPON OATH, STATE THAT THIS WELL RECORD IS TRUE AND CORRECT ACCORDING TO THE RECORDS OF THIS OFFICE AND TO THE BEST OF MY KNOWLEDGE AND BELIEF.

SUBSCRIBED AND SWORN TO BEFORE ME THIS 15th DAY OF March 1957

MY COMMISSION EXPIRES

ORIGINAL SIGNED BY W. M. WARREN ORIGINAL SIGNED BY L. G. CHERRY NOTARY PUBLIC

FORMATION RECORD

DESCRIBE EACH FORMATION DRILLED. INDICATE THICKNESS, CONTENT AND WHETHER DRY, OR OIL, GAS, OR WATER BEARING.

FORMATION	TOP	BOTTOM	FORMATION	TOP	BOTTOM
Shale	0	157	Line, Shale	3407	3432
Red Shale	157	200	Line	3432	3481
Blue Shale	200	360	Line, Shale	3481	3597
Redbed	360	670	Line	3597	3650
Red Shale	670	1010	Shale, Line	3650	3710
Redbed, Line	1010	1130	Line, Shale	3710	3890
Redbed, Sand str.	1130	1395	Line	3890	4172
Anhy str.	1395	1430	Line, Shale	4172	4464
Anhy	1430	1509	Shale, Line	4464	4510
Red Bed, Anhy	1509	1835	Line, Shale	4510	4705
Redbed	1835	2067	Shale, Line	4705	4776
Line of Shale	2067	2208	Line, Shale	4776	4833
Sand, Line, Shale	2208	2315	Shale	4833	4902
Line, Shale	2315	2540	Line, Shale	4902	4949
Shale, Line	2540	2561	Shale	4949	5014
Line, Shale	2561	2677	Shale, Line	5014	5150
Line	2677	2724	Shale	5150	5270
Line, Shale	2724	2927	Shale, Line	5270	5330
Line	2927	2963	Shale, Sand	5330	5378
Shale, Line	2963	3044	Line, Shale	5378	5450
Line, Shale	3044	3217	Line	5450	5481
Shale, Line	3217	3255			
Line, Shale	3255	3344	TD 5481'		
Line, Shale, Cherty Line	3344	3407	PBD 5379'		

Summary of Drilling and Completion Operations:

Operations commenced 12-19-56

Spudded 12-21-56

Bottom of Collar to ground level 4.65'

Ground level to Rotary Drive Bushing 9.15'

Elevation: Ground level 3398'

Derrick Floor 3405'

Rotary Drive Bushing 3407'

8-5/8" casing set at 1509' w/400 sz. Foamix #1 cement w/2% Calcium Chloride. Cement did not cure. Ben Schlusberger Laterolog, Microlaterolog, Self-Potential Log & Gamma Ray Log w/tops:

- Herington 2166'
- Winfield 2224'
- Tepeka 3154'
- Lansing 3488'
- Missouri 3618'
- Des Moines 4272'
- Narrow 4878'
- Mississippi 5426'

5 1/2" casing 5450' w/1300 sz. Foamix #1 cement. 400 sz. below and 900 sz. above DV Multiple Stage Cementer. Permanent Bench Mark 11.06' above side outlets in 8-5/8" Braden Head. Total Depth 5481'. Plugged Back Depth 5379'.

DST #1, 2164-2208'. Gas to surface in 10 min. 1 hour gauge 251 WCF/D. Recovered 360' gas out mud. Initial flow 90%, final flow 110%. BHP 500%. Hydrostatic Head 990%.

DST #2, 3291-3344'. Weak blow, drying in 50 min. Tool closed 30 min. Recovered 60' gas out mud. Initial flow 0, final 80%. BHP 530%. Initial Hydrostatic Head 1710%, Final 1630%.

DST #3, 4252-93'. Open 1 hr, closed 20 min. Weak blow for 20 min. Recovered 7' mud. Initial and final flow 20%. BHP 110%. Hydrostatic Head 1950%.

DST #4, 5079-5150'. Open 1 hr, closed 1/2 hr. Fair blow. Recovered 180' gas out mud. Initial flow 60%, final flow 110%, BHP 740%, Hydrostatic Head 2450%.

DST #5, 5317-79'. Open 1 hr, closed 1/2 hr. Gas to surface in 9 min. 1 hr. gauge 1020 WCF/D. Recovered 270' Hvy. GCM. Final flow 210%. BHP 1340%. Hydrostatic Head 2900%.

DST #6, 5403-81'. Open 1 hr, closed 1/2 hr. Recovered 120' GCM w/brown stain. Initial flow 10%, final flow 40%. Hydrostatic Head 2650%.