


15-129-10141-00-00

WELL PLUGGING RECORD

Give All Information Completely
Make Required Affidavit
Mail or Deliver Report to:
Conservation Division
State Corporation Commission
211 No. Broadway
Wichita, Kansas

Morton County, Sec. 21 Twp. 31 Rge. (E) 41 (W)

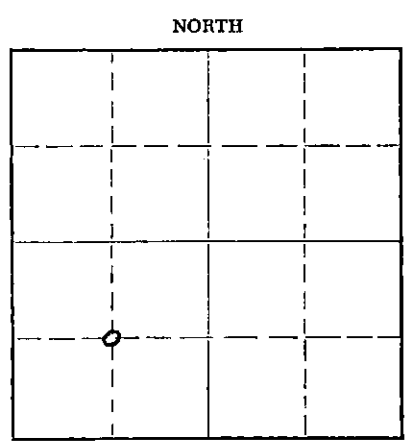

Locate well correctly on above Section Plat

Location as "NE/CNW%SW%" or footage from lines C SW
Lease Owner Panhandle Eastern Pipe Line Company
Lease Name Behn Well No. 1-21
Office Address Box 351 Liberal, Kansas
Character of Well (completed as Oil, Gas or Dry Hole) Dry Hole
Date well completed October 29 19 58
Application for plugging filed October 29 19 58
Application for plugging approved October 29 19 58
Plugging commenced October 29 19 58
Plugging completed October 30 19 58
Reason for abandonment of well or producing formation Dry Hole

If a producing well is abandoned, date of last production 19
Was permission obtained from the Conservation Division or its agents before plugging was commenced? Yes

Name of Conservation Agent who supervised plugging of this well Merle Rives
Producing formation _____ Depth to top _____ Bottom _____ Total Depth of Well 5380 Feet
Show depth and thickness of all water, oil and gas formations.

OIL, GAS OR WATER RECORDS

CASING RECORD

FORMATION	CONTENT	FROM	TO	SIZE	PUT IN	PULLED OUT
Morrow Sand		5018	5029	8-5/8	2297	
Morrow Sand		5072	5080	4-1/2	5288	2447
Morrow Sand		5138	5209			
Morrow Sand		5218	5274			
Morrow Sand		5342	5351			
Mississippian		5351				

Describe in detail the manner in which the well was plugged, indicating where the mud fluid was placed and the method or methods used in introducing it into the hole. If cement or other plugs were used, state the character of same and depth placed, from _____ feet to _____ feet for each plug set.

Spotted 25 sacks cement at 2180'. Top of cement at 2030'. Filled hole with mud to 500'. Set B-plug at 500' w/10 sacks cement on top. Filled hole to 157 w/mud. Filled hole from 157' to surface w/25 sacks cement.

(If additional description is necessary, use BACK of this sheet)

Name of Plugging Contractor Andrews Cable Tool
Address Liberal, Kansas

STATE OF Kansas, COUNTY OF Seward, ss.
Eddie Myers (employee of owner) or (owner or operator) of the above-described well, being first duly sworn on oath, says: That I have knowledge of the facts, statements, and matters herein contained and the log of the above-described well as filed and that the same are true and correct. So help me God.

(Signature) Eddie Myers Jr.
P.O. Box 351, Liberal, Kansas
(Address)

SUBSCRIBED AND SWORN TO before me this 6th day of November, 1958
Carl F. Halland

My Commission Expires November 14, 1960
My commission expires _____

Notary Public.

PLUGGING
FILE SEC 21 T. 31 R. 41 W
BOOK PAGE 141 LINE 7

NOV 7 1958
11-7-58
CONSERVATION DIVISION
WICHITA, KANSAS

DRILLER'S LOG

15-129-10141-0000

WELL NAME: Behm; COMPANY OPERATING: Panhandle Eastern Pipe Line Co;
 ADDRESS of COMPANY: Box 351, Liberal, Kansas;
 WELL LOCATION: C 1/4 SW 1/4 1/4,
1320 ft. North of South line,
1320 ft. East of West line; Sec. 21, Twp. 31, Rge. 41, Morton County, Kansas
 DRILLING STARTED September 10, 1958; DRILLING COMPLETED October 6, 1958
 WELL COMPLETED October 30, 1958; WELL CONNECTED _____, 19____
 ELEVATION: 3410 ft. Ground Level; CHARACTER OF WELL (Oil, Gas, or Dry Hole) Dry Hole

OIL OR GAS SANDS OR ZONES - PERFORATIONS - ACIDIZING AND FRACTURING INFORMATION					
Name	From	To	No. of Shots	Gallons Used	Kind Used
Morrow Sand	5224	5234	40	1000	15%
Up. Morrow Sand	5072	5077	20	1000	15%
Lansing	3994	3998	8		
Lansing	4025	4053	56	5000	15%
Topeka	3059	3137	60	3000	15%
Krider	2154	2159	20	1000	15%
Krider	2165	2175	40	2000	15%
Winfield	2717	2727	40	1000	15%

CASING RECORD

Size	Amount Set	Sacks of Cement	Amount Pulled
8-5/8"	2297	400	0
4-1/2"	5288	200	2447

FORMATION RECORD

Formation	Top	Bottom	Formation	Top	Bottom
Sand & Red Bed	0		Lime	4575	4630
Red Bed & Shale & Shells	1030		Lime & Shale	4630	4985
Red Bed & Lime	1340		Shale	4985	5082
Shale & Shells	1725		Shale & Sand	5082	5370 TD
Shale & Anhy	2025		FORMATION TOPS:		
Shale	2310		Krider	2151	
Shale & Anhy	2395		Winfield	2217	
Sand & Shale	2517		Topeka	3134	
Shale & Shells	2607		Lansing	3689	
Shale & Lime	2740		Cherokee	4428	
Shale & Sand w/lime streaks	2832		Up. Morrow Sand Zone	5018	29
Shale	3007		Up. Morrow Sand	5072	80
Lime & Shale	3263		Morrow Sand	5218	
Lime	3526		Morrow Sand	5218	
Lime & Shale	4501		Basal Morrow Sand	5351	
RESULTS of INITIAL PRODUCTION TEST:			Mississippian	5351	

PLUGGING
 FILE SEC 21 T 31 R 41W
 BOOK PAGE 141 LINE 7

STATE COMMISSION
 NOV 7 1958

CONSERVATION DIVISION
 Wichita, Kansas