


Give All Information Completely
Make Required Affidavit
Mail or Deliver Report to:
Conservation Division
State Corporation Commission
211 No. Broadway
Wichita, Kansas

WELL PLUGGING RECORD

Morton County, Sec. 29 Twp. 31 Rge. 41W (E) (W)

Location as "NE/CNW/SW" or footage from lines C SW NW
Lease Owner Alamo Corporation
Lease Name Kansas University Well No. 1
Office Address 2010 34th St., Lubbock, Texas
Character of Well (completed as Oil, Gas or Dry Hole) Dry hole
Date well completed 12/15 19 62
Application for plugging filed 12/15 verbally 19 62
Application for plugging approved 12/15 verbally 19 62
Plugging commenced 12/15 19 62
Plugging completed 12/15 19 62
Reason for abandonment of well or producing formation Dry hole

If a producing well is abandoned, date of last production _____ 19 ____
Was permission obtained from the Conservation Division or its agents before plugging was commenced? Yes

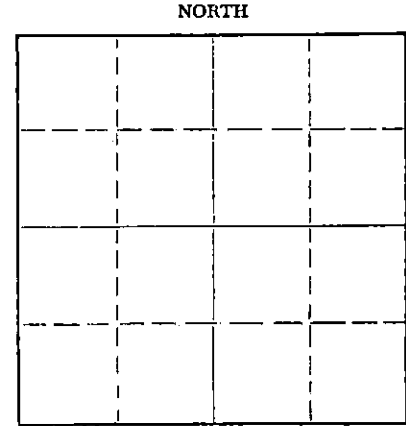

Locate well correctly on above Section Plat

Name of Conservation Agent who supervised plugging of this well W. L. Lackamp, Jr.
Producing formation _____ Depth to top _____ Bottom _____ Total Depth of Well 5480 Feet
Show depth and thickness of all water, oil and gas formations.

OIL, GAS OR WATER RECORDS

CASING RECORD

FORMATION	CONTENT	FROM	TO	SIZE	PUT IN	PULLED OUT
				8 5/8"	1494'	None

Describe in detail the manner in which the well was plugged, indicating where the mud fluid was placed and the method or methods used in introducing it into the hole. If cement or other plugs were used, state the character of same and depth placed, from _____ feet to _____ feet for each plug set.

#1 plug @ 4900 w/2sacks common cement w/water cushion, #2 plug @ 1450 w/15 sacks with water cushion, top plug @ 40' w/10 sacks cement to surface.

RECEIVED
STATE CORPORATION COMMISSION

DEC 26 1962

CONSERVATION DIVISION
WICHITA, KANSAS

(If additional description is necessary, use BACK of this sheet)

Name of Plugging Contractor _____
Address _____

STATE OF KANSAS, COUNTY OF RUSSELL, ss.
Donald L. Roberts (employee of owner) or (owner or operator) of the above-described well, being first duly sworn on oath, says: That I have knowledge of the facts, statements, and matters herein contained and the log of the above-described well as filed and that the same are true and correct. So help me God. ROBERTS DRILLING CO. (Contractor)
(Signature) By [Signature]
Russell, Kansas
(Address)

SUBSCRIBED AND SWORN TO before me this 20th day of December, 19 62

[Signature]
Notary Public.

My commission expires 6/17/66



15-129-10001-0000

ALAMO CORPORATION
KANSAS UNIVERSITY #1

R. T. D. 5480

Commenced 11/29/62
Completed 12/15/62

C SW NW Section 29-31-41W,
Morton County, Kansas

CONTRACTOR: Roberts Drilling Company

Set 8 5/8" Casing @ 1494' with 650 sx.

Surface Soil & Sand	40'
Red Bed & Shale	1030
Gypsum & anhydrite streaks	1090
Red Bed & Shale	1398
Red Bed	1484
Anhydrite	1505
Red Bed	1900
Shale & Lime Streaks	2050
Shale & Lime	3279
Chalky Lime	3360
Lime & Chalk Streaks	3442
Lime	4164
Lime & Shale	5480

RECEIVED
STATE CONSERVATION COMMISSION

DEC 26 1962

CONSERVATION DIVISION
Wichita, Kansas

STATE OF KANSAS)
RUSSELL COUNTY) SS.

I hereby certify that the above information is correct to the best
of my knowledge.

ROBERTS DRILLING COMPANY

By Donald J. [Signature]

Subscribed and sworn to before me this 20th day of December, 1962.

[Signature]
Notary Public

My Commission Expires 6/17/66