

15-129-10005-0000


STATE OF KANSAS
STATE CORPORATION COMMISSION

Give All Information Completely
Make Required Affidavit
Mail or Deliver Report to
Conservation Division
State Corporation Commission
211 No. Broadway
Wichita, Kansas

WELL PLUGGING RECORD

Morton County, Sec. 32 Twp. 31S Rg. (E) 41 (W)
Location as "NE/CNW&SW" or footage from lines CSWSW
Lease Owner: Amarillo Oil Company
Lease Name: P. L. Hanke Well No. 1
Office Address: P. O. Box 151 - Amarillo, Texas
Character of Well (completed as Oil, Gas or Dry Hole) Dry Hole
Date well completed November 25, 1964
Application for plugging filed November 25, 1964
Application for plugging approved November 25, 1964
Plugging commenced November 26, 1964
Plugging completed November 26, 1964
Reason for abandonment of well or producing formation Dry Hole

NORTH

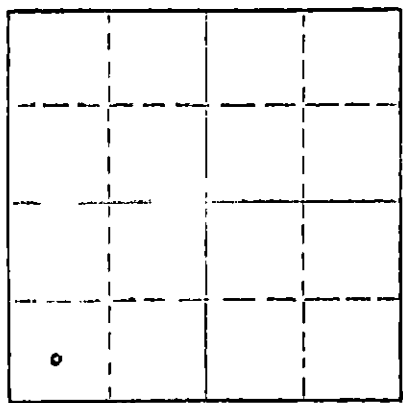

Locate well correctly on above
Section Flat

If a producing well is abandoned, date of last production _____ 19____
Was permission obtained from the Conservation Division or its agents before plugging was commenced? Yes

Name of Conservation Agent who supervised plugging of this well Hugh Scott
Producing formation None Depth to top _____ Bottom _____ Total Depth of Well 5650 Feet
Show depth and thickness of all water, oil and gas formations.

OIL, GAS OR WATER RECORDS

CASING RECORD

FORMATION	CONTENT	FROM	TO	SIZE	PUT IN	PULLED OUT
LeCompton	Dry	3480	3694	8-5/8"OD	1471'	None
Lansing	Dry	3694	4342			
Marmaton	Dry	4242	4452			
Cherokee	Dry	4452	4883			
Morrow	Dry	4883	5385			
Chester	Dry	5385	5415			
StGenevieve	Dry	5414	5554			
St. Louis	Dry	5554	5650			

Describe in detail the manner in which the well was plugged, indicating where the mud fluid was placed and the method or methods used in introducing it into the hole. If cement or other plugs were used, state the character of same and depth placed, from _____ feet to _____ feet for each plug set.
Filled hole with drilling mud weighing 9.3#/gal, viscosity 49, water loss 8.8, 8# ICM/bbl. Spotted 35 sx cement plug from 5180 to 5300. Spotted 50 sx cement plug from 964 to 800'. Spotted 15 sx cement plug from 0 to 45.

RECEIVED
STATE CORPORATION COMMISSION

DEC 10 1964

CONSERVATION DIVISION
Wichita, Kansas

(If additional description is necessary, use BACK of this sheet)

Name of Plugging Contractor _____
Address _____

STATE OF TEXAS COUNTY OF POTTER, ss.
J. A. Tipton (employee of owner) or (owner or operator) of the above-described well, being first duly sworn on oath, says: That I have knowledge of the facts, statements, and matters herein contained and the log of the above-described well as filed and that the same are true and correct. So help me God.

(Signature) J. A. Tipton Prod. Supt.
Amarillo Oil Co. - Box 151 - Amarillo, Texas
(Address)

Subscribed and Sworn to before me this 8th day of December, 1964
Darla Crouch (Darla Crouch)
Notary Public.

My commission expires June 1, 1965

P. 1: HANKE WELL NO. 1

CONTRACTORS: THE R. W. RINE DRILLING COMPANY

STARTED: NOVEMBER 10, 1964

660' FSL & 660' FWL
SECTION 32-31S-41W
MORTON COUNTY, KANSAS

15-129-10005-0000

COMPLETED: NOVEMBER 25, 1964

L O G

Surface Clay, Shells	0' - 238'
Red Bed	238' - 1000'
Gypsum & Anhydrite Streaks	1000' - 1110'
Glorietta Sand	1110' - 1268'
Sand	1268' - 1457'
Anhydrite	1457' - 1478'
Shale	1478' - 2748'
Shale & Lime	2748' - 3237'
Chalky Lime	3237' - 3375'
Shale & Chalky Lime	3375' - 3509'
Lime	3509' - 3752'
Lime & Shale	3752' - 3882'
Lime	3882' - 4673'
Lime & Shale	4673' - 4905'
Lime	4905' - 5117'
Lime, Shale & Sand	5117' - 5220'
Sand, Lime	5220' - 5260'
Lime	5260' - 5269'
Sand & Lime	5269' - 5280'
Lime & Shale	5280' - 5298'
Lime	5298' - 5485'
Lime & Chert	5485' - 5650'

Totco @ 400', 1°; 700', 1/2°

Totco @ 1472', 3/4°
8 5/8" @ 1471' w/675 sxs. poz.
Totco @ 2100', 0°; @ 2553', 1/4°

Totco @ 3752', 1 1/2°
Totco @ 4074', 1 1/4°
Totco @ 4317', 1°
Totco @ 4718', 3/4°
Totco @ 5010', 3/4°

RECEIVED
STATE CORPORATION COMMISSION

DEC 10 1964

CONSERVATION DIVISION
Wichita, Kansas

Totco @ 5525', 1 1/8°
D&A 35 sx. @ 5300'; 50 sx. @ 964'

STATE OF KANSAS)
COUNTY OF SEDGWICK)

ss

I, R. M. Green, do hereby certify that the above is a true and accurate log of the P. L. Hanke Well No. 1, located 660' FSL & 660' FWL of Section 32-31S-41W, Morton County, Kansas.


R. M. Green, Secretary-Treasurer

Subscribed and sworn to before me this 30th day of November, 1964.


Loren E. Lake, Notary Public

My Commission Expires: 6/14/66