


WELL PLUGGING RECORD 15-129-10003-0000

Give All Information Completely
Make Required Affidavit
Mail or Deliver Report to:
Conservation Division
State Corporation Commission
211 No. Broadway
Wichita, Kansas

Morton County, Sec. 32 Twp. 31 Rge. 41 (E) W (W)
Location as "NE/CNW/SW" or footage from lines SW/SE
Lease Owner Bovaird Supply Co.
Lease Name Hanke Well No. 1
Office Address 525 S. Western, Liberal, Kansas 67901
Character of Well (completed as Oil, Gas or Dry Hole) Gas Well
Date well completed 9/25/62 1969
Application for plugging filed 1969
Application for plugging approved 1969
Plugging commenced 6/8/69 1969
Plugging completed 6:30 p.m. 6/9/69 1969
Reason for abandonment of well or producing formation Production declined to an uneconomic level
If a producing well is abandoned, date of last production April 1969
Was permission obtained from the Conservation Division or its agents before plugging was commenced? Yes

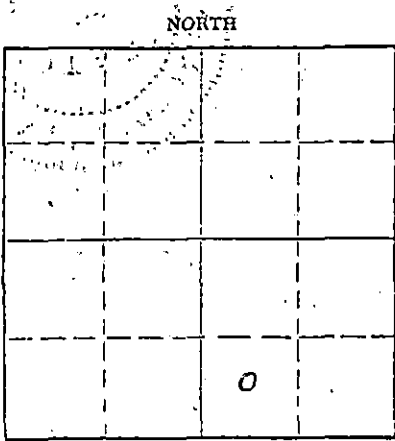

Locate well correctly on above Section Plat

Name of Conservation Agent who supervised plugging of this well _____
Producing formation Morrow Depth to top 5245 Bottom 5250 Total Depth of Well 5340 Feet
Show depth and thickness of all water, oil and gas formations.

OIL, GAS OR WATER RECORDS

CASING RECORD

FORMATION	CONTENT	FROM	TO	SIZE	PUT IN	PULLED OUT
<u>Morrow</u>	<u>Gas</u>	<u>5245</u>	<u>5250</u>	<u>8 5/8</u>	<u>1504</u>	
				<u>4 1/2</u>	<u>5340</u>	

Describe in detail the manner in which the well was plugged, indicating where the mud fluid was placed and the method or methods used in introducing it into the hole. If cement or other plugs were used, state the character of same and depth placed, from _____ feet to _____ feet for each plug set.

20 sks. on bottom
Top 5,050'
35 sks. 900' to 800'
15 sks. 45' to 0'


Pulled 3,042.92' - 5 1/2"

RECEIVED
STATE CORPORATION COMMISSION
JUL 8 1969
CONSERVATION DIVISION
Wichita, Kansas

(If additional description is necessary, use BACK of this sheet)
Name of Plugging Contractor Sargent's Casing Pulling Service
Address P. O. Box 506, Liberal, Kansas 67901

STATE OF KANSAS COUNTY OF SEWARD ss.
Chester A. Nordling (~~employee or owner~~ or (owner or operator) of the above-described well, being first duly sworn on oath, says: That I have knowledge of the facts, statements, and matters herein contained and the log of the above-described well as filed and that the same are true and correct. So help me God.

(Signature) Chester A. Nordling, Partner
Liberal, Kansas (Address)

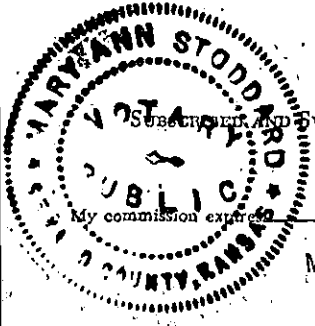

Subscribed and sworn to before me this 16th day of June, 1969
Maryann Stoddard
Notary Public.

ALAMO CORPORATION

C SW SE Sec. 32-31-41W
Morton County, Kansas

HANKE #1

CONTRACTOR: Roberts Drilling Co.

RTD 5344

Commenced 4/25/62
Completed 5/13/62

Set 8 5/8" @ 1504' w/600-sx cmt.
Set 5 1/2" @ 5343' w/150-sx cmt.

15-129-10003-0000

Surface Soil & Sand	215
Sand, Shale & Red Bed	650
Red Bed & Shale	1050
Gypsum & Anhydrite Stks.	1182
Shale w/stk. gyp.	1374
Red Bed & Shale	1494
Anhydrite	1514
Red Bed & Shale	1810
Shale & Lime Streaks	2120
Red Bed	2182
Shale & Lime	2707
Lime	2846
Lime & Shale	3390
Lime & Chalk Streaks	3446
Lime, Shale, Chalk Stks.	3555
Lime & Shale	4036
Lime	4665
Lime & Shale	4794
Lime & Shale Streaks	4915
Lime & Shale	5098
Shale & Sand	5135
Lime & Shale	5163
Lime	5192
Sand & Shale	5233
Lime & Shale	5260
Lime	5266
Lime & Sand	5312
Lime	5344

STATE OF KANSAS)
RUSSELL COUNTY) SS.

I hereby certify that the above information is correct to the best of my knowledge.

ROBERTS DRILLING CO.

By Melvin Bellamy

Subscribed and sworn to before me this 15th day of May, 1962.

Charles L. Lamm
Notary Public

My Commission Expires 6/17/62