


Give All Information Completely
Make Required Affidavit
Mail or Deliver Report to:
Conservation Division
State Corporation Commission
P. O. Box 17027
Wichita, Kansas 67217
NORTH

WELL PLUGGING RECORD

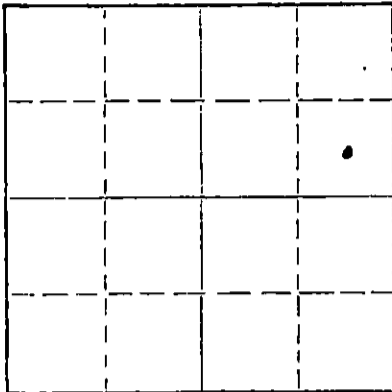

Locate well correctly on above Section Flat

Morton County, Sec. 32 Twp. 31S Rge. (X) 41 (W)
Location as "NE/CNW/SW" or footage from lines "SE 1/4 NE 1/4"
Lease Owner Roger M. Wheeler
Lease Name Kansas University Endowment Well No. 1
Office Address P. O. Box 1526, Tulsa, Oklahoma 74101
Character of Well (completed as Oil, Gas or Dry Hole) Dry Hole
Date well completed June 6 19 75
Application for plugging filed June 6 19 75
Application for plugging approved June 6 19 75
Plugging commenced June 6 19 75
Plugging completed June 6 19 75
Reason for abandonment of well or producing formation _____

If a producing well is abandoned, date of last production _____ 19____
Was permission obtained from the Conservation Division or its agents before plugging was commenced? Yes

Name of Conservation Agent who supervised plugging of this well _____
Producing formation _____ Depth to top _____ Bottom _____ Total Depth of Well 5367 Feet
Show depth and thickness of all water, oil and gas formations.

OIL, GAS OR WATER RECORDS

CASING RECORD

FORMATION	CONTENT	FROM	TO	SIZE	PUT IN	PULLED OUT
				8 5/8"	1490'	None

Describe in detail the manner in which the well was plugged, indicating where the mud fluid was placed and the method or methods used in introducing it into the hole. If cement or other plugs were used, state the character of same and depth placed, from _____ feet to _____ feet for each plug set.

Drilling Mud 5367' to 2700'
Cement 2700' to 2613' With 25 Sacks
Drilling Mud 2613' to 2400'
Cement 2400' to 2313' With 25 Sacks
Drilling Mud 2313' to 2100'
Cement 2100' to 1913' With 25 Sacks
Drilling Mud 1913' to 1540'
Cement 1540' to 1440' With 30 Sacks
Drilling Mud 1440' to 40'
Cement 40' to 0' With 15 Sacks & 15 Sacks in the Rat Hole

RECEIVED
STATE CORPORATION COMMISSION

JUN 18 1975

CONSERVATION DIVISION
Wichita, Kansas

(If additional description is necessary, use BACK of this sheet)

Name of Plugging Contractor Earl F. Wakefield, Inc.
Address 300 West Douglas, Suite 500, Wichita, Kansas 67202

STATE OF Oklahoma, COUNTY OF Tulsa, ss.
Roger M. Wheeler (employee of owner) or (owner or operator) of the above-described well, being first duly sworn on oath, says: That I have knowledge of the facts, statements, and matters herein contained and the log of the above-described well as filed and that the same are true and correct. So help me God.

(Signature)

P.O. Box 1526, Tulsa, Oklahoma 74101
(Address)

SUBSCRIBED AND SWORN TO before me this 16th day of June, 19 75

Arlene Wasson

My commission expires November 7, 1978

Notary Public.

DRILLER'S LOG

15-129-20201-0000

LEASE NAME: KANSAS UNIVERSITY ENDOWMENT #1 LOCATION: C SE/4 NE/4
 OPERATOR : ROGER M. WHEELER SECTION 32-21S-41W
 CONTRACTOR: EARL F. WAKEFIELD, INC. MORTON COUNTY, KANSAS
 SPUD DATE : 5-22-75 CASING: 8 5/8" SET @ 1490'
 DRILL COMP: 6-5-75

Sand & Red Bed	994
Gyp & Sand	1165
Red Bed & Gyp - Anhydrite	1490
Red Bed - Anhydrite	2237
Sand & Shale	2499
Line & Shale	2928
Shale & Line	3722
Line & Shale	3797
Shale & Line	4012
Line & Shale	4104
Shale & Line	4286
Shale	4900
Shale & Line	5137
Shale & Sand	5238
Sand & Shale	5316
Shale - Sand	5367
R.T.D.	5367

MILLERS FALLS
 UNION BURN
 DOTTEN COMPANY

RECEIVED
 DIVISION
 JUL 17 1975
 DIVISION

STATE OF KANSAS)
) ss.
 COUNTY OF SEDGWICK)

I, Gerald L. Mason, do hereby certify that this is a true and correct log on the KANSAS UNIVERSITY ENDOWMENT #1, located NE SW NE, Section 32-31S-41W, Morton County, Kansas, as shown by the daily reports.

EARL F. WAKEFIELD, INC.
 By Gerald L. Mason
 Gerald L. Mason

Subscribed and Sworn to before me this 11th Day of June, 1975.
 My Commission Expires:
 October 22, 1976

Carol Jean Noel
 Carol Jean Noel - Notary Public

