


Give All Information Completely  
Make Required Affidavit -  
Mail or Deliver Report to:  
Conservation Division  
State Corporation Commission  
211 No. Broadway  
Wichita, Kansas

15-128-10028.0000  
**WELL PLUGGING RECORD**

NORTH

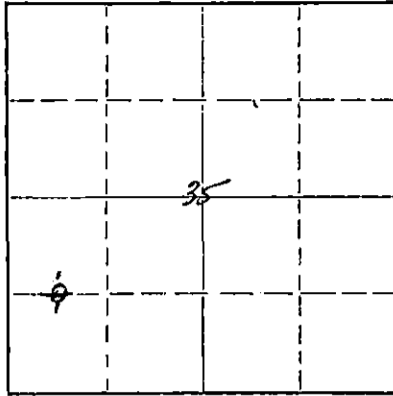

Locate well correctly on above  
Section Plat

Morton County, Sec. 35 Twp. 31S Rge. 41W (E) (W)  
Location as "NE/CNW/SW" or footage from lines C W/2 SW/4  
Lease Owner The Hefner Production Company  
Lease Name Daniel Well No. 1  
Office Address 720 N.W. 50th St., Okla. City, Okla.  
Character of Well (completed as Oil, Gas or Dry Hole) Dry Hole  
Date well completed July 30, 19 62  
Application for plugging filed " 19 62  
Application for plugging approved " 19 62  
Plugging commenced July 30, 19 62  
Plugging completed July 30, 19 62  
Reason for abandonment of well or producing formation Dry Hole

If a producing well is abandoned, date of last production 19  
Was permission obtained from the Conservation Division or its agents before plugging was commenced? Yes

Name of Conservation Agent who supervised plugging of this well Hugh Scott, Box 1223, Liberal, Kansas  
Producing formation None Depth to top          Bottom          Total Depth of Well 5622' Feet  
Show depth and thickness of all water, oil and gas formations.

OIL, GAS OR WATER RECORDS

CASING RECORD

FORMATION	CONTENT	FROM	TO	SIZE	PUT IN	PULLED OUT
				8 5/8"	1497'	None

Describe in detail the manner in which the well was plugged, indicating where the mud fluid was placed and the method or methods used in introducing it into the hole. If cement or other plugs were used, state the character of same and depth placed, from          feet to          feet for each plug set.

35 sx. Cement plug was placed in bottom of surface pipe 1497', came up to 1263'. Then 15 sx plug was placed in top of surface pipe.

**RECEIVED**  
STATE CORPORATION COMMISSION  
AUG 29 1962  
7-29-62  
CONSERVATION DIVISION  
Wichita, Kansas

(If additional description is necessary, use BACK of this sheet)

Name of Plugging Contractor Holm Drilling Company  
Address 1036 E. 38th Pl., Tulsa, Oklahoma

STATE OF Oklahoma, COUNTY OF Oklahoma, ss.  
Harry H. Hurd (employee of owner) or (owner or operator) of the above-described well, being first duly sworn on oath, says: That I have knowledge of the facts, statements, and matters herein contained and the log of the above-described well as filed and that the same are true and correct. So help me God.

(Signature) Harry H. Hurd  
720 N.W. 50th St., Okla. City, Okla.  
(Address)

SUBSCRIBED AND SWORN TO before me this 27th day of August, 19 62

Emeline Culver  
Notary Public.

My commission expires February 14, 1965

