


WELL PLUGGING RECORD

Give All Information Completely
Make Required Affidavit
Mail or Deliver Report to:
Conservation Division
State Corporation Commission
211 No. Broadway
Wichita, Kansas

Meade County. Sec. 23 Twp. 33S Rge. 28W (E) (W)

NORTH

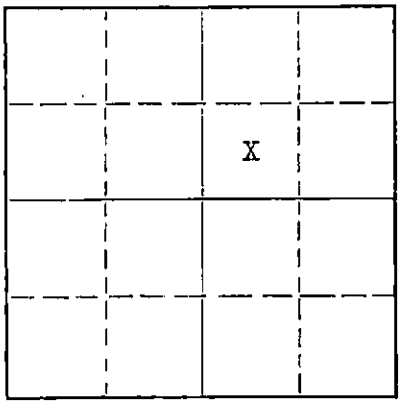

Locate well correctly on above
Section Plat

Location as "NE/CNW/SW" or footage from lines C-SW-NE
Lease Owner Sunray DX Oil Company
Lease Name Dick Classen Well No. 1
Office Address 321 West Douglas, Wichita 2, Kansas
Character of Well (completed as Oil, Gas or Dry Hole) Dry Hole
Date well completed _____ 19____
Application for plugging filed July 11, 1963
Application for plugging approved July 15, 1963
Plugging commenced July 11, 1963
Plugging completed July 11, 1963
Reason for abandonment of well or producing formation Non-Commerical

If a producing well is abandoned, date of last production _____ 19____
Was permission obtained from the Conservation Division or its agents before plugging was commenced? Yes

Name of Conservation Agent who supervised plugging of this well _____
Producing formation _____ Depth to top _____ Bottom _____ Total Depth of Well 6000 Feet
Show depth and thickness of all water, oil and gas formations.

OIL, GAS OR WATER RECORDS CASING RECORD

FORMATION	CONTENT	FROM	TO	SIZE	PUT IN	PULLED OUT
				8 5/8"	1550'	0'

Describe in detail the manner in which the well was plugged, indicating where the mud fluid was placed and the method or methods used in introducing it into the hole. If cement or other plugs were used, state the character of same and depth placed, from _____ feet to _____ feet for each plug set.
Filled hole with mud from total depth to 750'. Place 1/2 sack of hulls and 35 sacks of cement at 750'. Filled with mud to 40' and place 1/2 sack of hulls and 15 sacks of cement. Place 5 sacks of cement in mouse hole and rat hole. Well plugged and abandoned 7-11-63.

RECEIVED
STATE CORPORATION COMMISSION
JUL 18 1963
7-18-1963
CONSERVATION DIVISION
Wichita, Kansas

(If additional description is necessary, use BACK of this sheet)
Name of Plugging Contractor Stickle Drilling Company
Address 1100 Bitting Building, Wichita, Kansas

STATE OF Kansas, COUNTY OF Sedgwick, ss.
Gary W. Pierce (employee of owner) or (owner or operator) of the above-described well, being first duly sworn on oath, says: That I have knowledge of the facts, statements, and matters herein contained and the log of the above-described well as filed and that the same are true and correct. So help me God.

(Signature) Gary W. Pierce
321 West Douglas, Wichita 2, Kansas
(Address)

SUBSCRIBED AND SWORN to before me this 17th day of July, 19 63

My commission expires July 13, 1967
Wes Montgomery Notary Public.

Sunray DX Oil Company
Tulsa, Oklahoma

Tulsa, Oklahoma
July 16, 1963

Contractor: Stickle Drilling Company
Date Commenced: June 20, 1963
Dated Completed: July 12, 1963

Dick Classen No. 1
SW NE Section 23-33S-28W
Meade County, Kansas

DRILLER'S LOG

Depth Figures Indicate Base of Formation:

Sand and red bed	223
Red bed and shells	820
Shale, sand and lime	1355
Shale and shells with streaks of anhydrite	1550
Lime and shale (anhydrite)	1685
Anhydrite	1728
Shale and shells	2540
Lime and shale	2920
Lime	3180
Lime and shale	3280
Lime	3531
Lime and shale	4305
Shale and lime	4515
Lime and shale	4625
Lime	5790
Shale and sand	5823
Lime	6000 TD

I, Fred E. Stickle, hereby certify the above to be a true and complete Driller's Log of Sunray DX Oil Company's Dick Classen No. 1 Well, SW NE Section 23-33S-28W, Meade County, Kansas.

Fred E. Stickle
FRED E. STICKLE

M. Mensley
Notary Public

My Commission Expires January 11, 1967

RECEIVED
STATE CORPORATION COMMISSION

JUL 18 1963

CONSERVATION DIVISION
Wichita, Kansas