


STATE OF KANSAS  
STATE CORPORATION COMMISSION

Form CP-4

Give All Information Completely  
Make Required Affidavit  
Mail or Deliver Report for  
Conservation Division  
State Corporation Commission

WELL PLUGGING RECORD

P. O. Box 17027  
Wichita, Kansas 67217  
NORTH

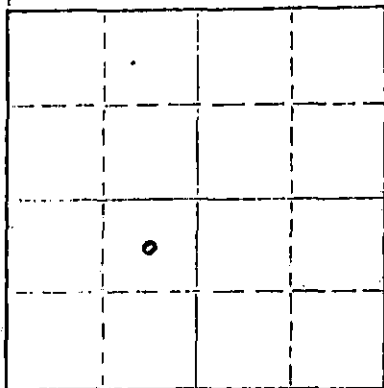

Locate well correctly on above  
Section Plat

Meade County, Sec. 25 Twp. 33S, Rge. 28 (X) (W)  
Location as "NE/CNW/SW" or footage from lines C NE SW  
Lease Owner Sidwell Oil & Gas, Inc.  
Lease Name Alfred Well No. 1  
Office Address P. O. Box 2475, Pampa, Texas 79065  
Character of Well (completed as Oil, Gas or Dry Hole) Dry hole  
Date well completed July 9 19 74  
Application for plugging filed July 9 19 74  
Application for plugging approved July 9 19 74  
Plugging commenced July 9 19 74  
Plugging completed July 9 19 74  
Reason for abandonment of well or producing formation

If a producing well is abandoned, date of last production 19  
Was permission obtained from the Conservation Division or its agents before plugging was commenced? yes

Name of Conservation Agent who supervised plugging of this well  
Producing formation Depth to top Bottom Total Depth of Well 6043 Feet  
Show depth and thickness of all water, oil and gas formations.

OIL, GAS OR WATER RECORDS CASING RECORD

FORMATION	CONTENT	FROM	TO	SIZE	PUT IN	PULLED OUT
				8 5/8"	724'	

Describe in detail the manner in which the well was plugged, indicating where the mud fluid was placed and the method or methods used in introducing it into the hole. If cement or other plugs were used, state the character of same and depth placed, from feet to feet for each plug set.  
35 sx 675' - 775'  
15 sx 0' - 40'

RECEIVED  
STATE CORPORATION COMMISSION  
JUL 16 1974  
CONSERVATION DIVISION  
Wichita, Kansas

Name of Plugging Contractor Zenith Drilling Corporation, Inc.  
Address Suite 600 - 200 West Douglas, Wichita, Kansas

STATE OF Kansas COUNTY OF Sedgwick, ss.  
C. Robert Buford (employee of owner) or (owner or operator) of the above-described

well, being first duly sworn on oath, says: That I have knowledge of the facts, statements, and matters herein contained and the log of the above-described well as filed and that the same are true and correct. So help me God.

(Signature) C. Robert Buford  
200 West Douglas, Suite 600, Wichita, Kansas (Address)

Subscribed and sworn to before me this 15th day of July, 19 74

My commission expires August 15, 1975  
Myrna D. Murphy Notary Public

# WELL LOG

COMPANY Sidwell Oil & Gas, Inc.  
 PO Box 2475, Pampa, Texas 79065  
 FARM Alfred NO. 1

SEC. 25-33S-28W

LOC. C NE SW


TOTAL DEPTH 6043'

COUNTY Meade County, Kansas

COMM. 6/25/74

COMP. 7/9/74

CONTRACTOR Zenith Drilling Corporation  
 Suite 600-200 West Douglas  
 Casing Wichita, Kansas  
 724' 8 5/8" w/500 sx cement.

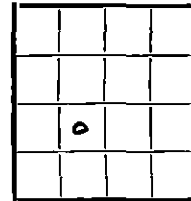

ELEVATION

PRODUCTION D & A

FIGURES INDICATE BOTTOM OF FORMATIONS

0	- 45'	Surface soil & Sand
45	- 915'	Redbed
915	-1412	Redbed & Anhydrite
1412	-1982	Redbed
1982	-2835	Shale & Lime
2835	-5661	Lime
5661	-5920	Lime & Shale
5920	-6043	Lime T. D.

RECEIVED  
 STATE CORPORATION COMMISSION  
 JUL 16 1974  
 CONSERVATION DIVISION  
 Wichita, Kansas

State of Kansas }  
 County of Sedgwick } ss

I, C. Robert Buford of Zenith Drilling Corporation  
 upon oath state the above and foregoing is a true and correct copy of the log of the Alfred #1 well.

C. Robert Buford  
 C. Robert Buford, President

Subscribed and sworn to before me this 15 day of July, 1974.

My Commission Expires: August 15, 1975

Myrna D. Murphy  
 Myrna D. Murphy NOTARY PUBLIC