


WELL PLUGGING RECORD

Give All Information Completely
 Make Required Affidavit

COUNTY Meade SEC. 29 TWP. 33 RGE. 28W E/W
 Location as in quarters or footage from lines:
 NW SW SW

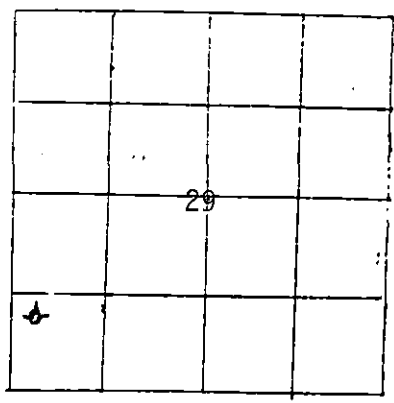

Lease Owner DONALD C. SLAWSON
 Lease Name BLEHM 'A' Well No. 2
 Office Address 200 Douglas Building Wichita, Kansas 67202
 Character of Well (Completed as Oil, Gas or Dry Hole): Dry Hole
 Date Well Completed June 21, 1982
 Application for plugging filed Yes
 Plugging commenced June 21, 1982
 Plugging completed June 21, 1982
 Reason for abandonment of well or producing formation Dry Hole

Locate Well
 correctly on above
 Section Platt.

Was permission obtained from the Conservation Division or it's
 Agent's before plugging was commenced? Yes

Name of Conservation Agent who supervised plugging of this well Paul Luthi

Producing formation _____ Depth to top _____ bottom _____ T.D. 5750'

Show depth and thickness of all water, oil and gas formations.

OIL, GAS OR WATER RECORDS Casing Record

Formation	Content	From	To	Size	Put in	Pulled Out
		surface	1521'	8 5/8"		

Describe in detail the manner in which the well was plugged, indicating where the mud
 fluid was placed and the method or methods used in introducing it into the hold. If cement
 or other plugs were used, state the character of same and depth placed, from _____ feet
 to _____ feet for each plug set.

1st plug @ 1560' w/60 sx
 2nd plug @ 780' w/25 sx
 Bridge @ 40' w/10 sx
 10 sx in Rat Hole

(If additional description is necessary, use BACK of this sheet)

Name of Plugging Contractor Halliburton Services
Box 579 Great Bend, Kansas 67530

STATE OF KANSAS COUNTY OF SEDGWICK, ss.
William R. Horigan (employee of owner) or (owner or operator) of the
 above-described well, being first duly sworn on oath, says: That I have knowledge of the
 facts, statements, and matters herein contained and the log of the above-described well as
 filed and that the same are true and correct. So help me God.

(Signature) William R. Horigan
William R. Horigan 200 Douglas Building
 (Address) Wichita, KS 67202

SUBSCRIBED AND SWORN TO before me this 29th day of November, 19 82

My Commission expires: 06/12/86
Sherry L. Kendall
 Notary Public
 STATE CORPORATION COMMISSION

DEC 10 1982
 CONSERVATION DIVISION
 Wichita, Kansas

15-119-20574-0000

BULK MATERIALS DELIVERY AND TICKET CONTINUATION

FOR INVOICE AND TICKET NO. 339515



DATE 6-21-82	CUSTOMER ORDER NO.	WELL NO. AND FARM Elehm 2-A	COUNTY Meade	STATE Kansas
CHARGE TO Slawson Drlg. Co.		OWNER Slawson Drlg. Co.	CONTRACTOR No. B112329	
MAILING ADDRESS		DELIVERED FROM Hugoton, Kansas	LOCATION CODE 50335	PREPARED BY Rick Rawlins
CITY & STATE		DELIVERED TO Loc. ES/Meade Lake, Kn.	TRUCK NO.	RECEIVED BY 1200 E. Slawson

PRICE REFERENCE	SECONDARY REF. OR PART NO.	CODE		DESCRIPTION	UNITS 1		UNITS 2		UNIT PRICE	AMOUNT
		L	D		QTY.	MEAS.	QTY.	MEAS.		
504-043				Southwestern Type II	105	sk			6.39	670 95
509-406				Calcium Chloride blended 2%	2	sk			21.00	42 00
			Returned Mileage Charge	TOTAL WEIGHT	LOADED MILES			TON MILES		
				SERVICE CHARGE ON MATERIALS RETURNED				CU. FEET		
500-207				SERVICE CHARGE				CU. FEET 109	.95	103 55
500-306			Mileage Charge	10,030 TOTAL WEIGHT	65 LOADED MILES			325.975 TON MILES	.70	228 18
No. B 112329				CARRY FORWARD TO INVOICE			SUB-TOTAL			

RECEIVED STATE COMPTROLLER'S OFFICE JUN 29 1982 CONSTRUCTION DIVISION Wichita Kansas