


15-119-00084-0000

WELL PLUGGING RECORD

STATE OF KANSAS
STATE CORPORATION COMMISSION
Give All Information Completely
Make Required Affidavit
Mail or Deliver Report to:
Conservation Division
State Corporation Commission
211 No. Broadway
Wichita, Kansas

Meade County. Sec. 36 Twp. 33S Rge. 28 KK (W)
Location as "NE/CNW%SW%" or footage from lines 2,310' from North and East lines
Lease Owner The Shamrock Oil and Gas Corporation
Lease Name C. J. Dirks "B" Well No. 1
Office Address Box 631, Amarillo, Texas
Character of Well (completed as Oil, Gas or Dry Hole) Dry Hole
Date well completed January 11, 19 58
Application for plugging filed January 11, 19 58
Application for plugging approved January 11, 19 58
Plugging commenced January 11, 19 58
Plugging completed January 11, 19 58
Reason for abandonment of well or producing formation Dry Hole

NORTH

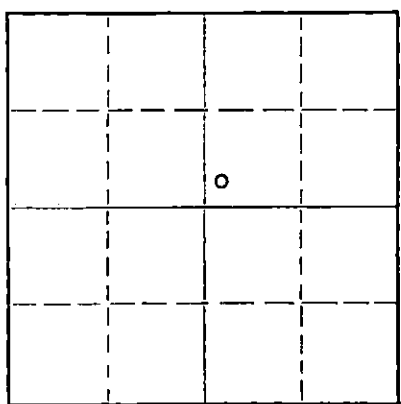

Locate well correctly on above Section Plat

If a producing well is abandoned, date of last production - 19 -
Was permission obtained from the Conservation Division or its agents before plugging was commenced? Yes

Name of Conservation Agent who supervised plugging of this well Merle Rives
Producing formation None Depth to top - Bottom - Total Depth of Well 6319 Feet
Show depth and thickness of all water, oil and gas formations.

OIL, GAS OR WATER RECORDS

CASING RECORD

FORMATION	CONTENT	FROM	TO	SIZE	PUT IN	PULLED OUT
Sand	Wtr.	650	-	13 3/8"	960	-0-

Describe in detail the manner in which the well was plugged, indicating where the mud fluid was placed and the method or methods used in introducing it into the hole. If cement or other plugs were used, state the character of same and depth placed, from - feet to - feet for each plug set.

Pushed 13 3/8" OD Halliburton plug to 550'. Spotted 35 sacks cement on top of plug.
Pushed 13 3/8" OD Halliburton plug to 20' below cellar. Filled casing with 15 sacks of cement.

RECEIVED
STATE CORPORATION COMMISSION
JAN 17 1958
CONSERVATION DIVISION
Wichita, Kansas

(If additional description is necessary, use BACK of this sheet)
Name of Plugging Contractor Halliburton Oil Well Cementing Company
Address Great Bend, Kansas

STATE OF TEXAS, COUNTY OF POTTER, ss.
T. S. Clopton (employee of owner) or (owner or operator) of the above-described well, being first duly sworn on oath, says: That I have knowledge of the facts, statements, and matters herein contained and the log of the above-described well as filed and that the same are true and correct. So help me God.

(Signature) T. S. Clopton
Box 631, Amarillo, Texas (Address)

SUBSCRIBED AND SWORN TO before me this 16th day of January 19 58
My commission expires 6-1-59
Pauline Powell Notary Public
Potter County, Texas

PLUGGING
FILE SEC 36 T. 33 R. 28
BOOK PAGE 76 LINE 14

C. J. DIRKS "B" NO. 1
 Section 36, Township 33 S. Range 28 W.
 Meade County, Kansas

0'	-	625'	Surface sand and red beds
625'	-	965'	Gyp and shale
965'	-	1,093'	Red beds and shale
1,093'	-	2,500'	Anhydrite and shale
2,500'	-	2,535'	Shale
2,535'	-	2,555'	Anhydrite
2,555'	-	2,565'	Dolomite and anhydrite
2,565'	-	2,595'	Anhydrite
2,595'	-	2,805'	Dolomite
2,805'	-	3,865'	Lime
3,865'	-	4,155'	Shale and lime streaks
4,155'	-	4,160'	Sand
4,160'	-	4,500'	Shale and lime streaks
4,500'	-	4,560'	Lime
4,560'	-	4,590'	Shale
4,590'	-	5,140'	Lime and shale streaks
5,140'	-	5,165'	Cherty lime
5,165'	-	5,760'	Lime with shale streaks
5,760'	-	5,770'	Shale
5,770'	-	5,800'	Lime and shale
5,800'	-	5,806'	Sand
5,806'	-	5,812'	Black shale
5,812'	-	5,814'	Lime and sandy lime
5,814'	-	5,820'	Lime
5,820'	-	5,828'	Green and black shale
5,828'	-	5,935'	Gray and black shale
5,935'	-	5,980'	Lime
5,980'	-	6,005'	Shale
6,005'	-	6,240'	Shale with lime streaks
6,240'	-	6,319'	Lime

RECEIVED
 STATE CORPORATION COMMISSION

JAN 16 1958

CONSERVATION DIVISION
 Wichita, Kansas

<p>PLUGGING</p> <p>FILE SEC 36 T 33 R 28 W</p> <p>BOOK PAGE 76 LINE 14</p>
