

15-119-20102-0000


STATE OF KANSAS
STATE CORPORATION COMMISSION

WELL PLUGGING RECORD

Give All Information Completely
Make Required Affidavit
Mail or Deliver Report to:
Conservation Division
State Corporation Commission
800 Bitting Building
Wichita, Kansas

Meade County. Sec. 5 Twp. 33S Rge. 29 (E) (W)
Location as "NE/CNW/SW" or footage from lines C NW/4 SW/4
Lease Owner Graham-Michaelis Corporation
Lease Name Bolan Well No. 1-5
Office Address 211 North Broadway, Wichita, Kansas 67202
Character of Well (completed as Oil, Gas or Dry Hole) Dry Hole
Date well completed July 1, 1972
Application for plugging filed verbal July 1, 1972
Application for plugging approved verbal July 1, 1972
Plugging commenced July 1, 1972
Plugging completed July 1, 1972
Reason for abandonment of well or producing formation Dry Hole

NORTH

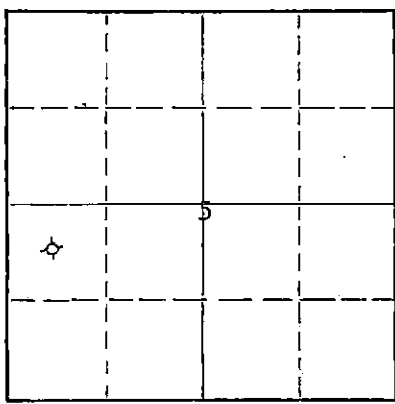

Locate well correctly on above
Section Plat

If a producing well is abandoned, date of last production 19
Was permission obtained from the Conservation Division or its agents before plugging was commenced? Yes, verbal

Name of Conservation Agent who supervised plugging of this well Edgar J. Eves, Sublette, Kansas
Producing formation none Depth to top Bottom Total Depth of Well 5900 Feet
Show depth and thickness of all water, oil and gas formations.

OIL, GAS OR WATER RECORDS

CASING RECORD

FORMATION	CONTENT	FROM	TO	SIZE	PUT IN	PULLED OUT
				8 5/8"	1585'	none

Describe in detail the manner in which the well was plugged, indicating where the mud fluid was placed and the method or methods used in introducing it into the hole. If cement or other plugs were used, state the character of same and depth placed, from feet to feet for each plug set.
Plugged with 35 sacks cement from 1100-1200',
cement plug from 3' below surface to 45'.

RECEIVED
STATE CORPORATION COMMISSION
JUL 11 1972
7-11-1972
CONSERVATION DIVISION
Wichita, Kansas

(If additional description is necessary, use BACK of this sheet)

Name of Plugging Contractor R. W. Rine Drilling Company
Address Suite 600, 300 West Douglas, Wichita, Kansas 67202

STATE OF Kansas, COUNTY OF Sedgwick, ss.
Jack L. Yinger (employee of owner) or (owner or operator) of the above-described well, being first duly sworn on oath, says: That I have knowledge of the facts, statements, and matters herein contained and the log of the above-described well as filed and that the same are true and correct. So help me God.

(Signature) Jack L. Yinger
Jack L. Yinger, 211 North Broadway, Wichita
(Address)

SUBSCRIBED AND SWORN TO before me this 3rd day of July, 1972.

My commission expires
MURIEL F. C. JERAM
NOTARY PUBLIC
SEDGWICK COUNTY, KANSAS
MY COMMISSION EXPIRES
JULY 25, 1976

Muriel F. C. Jeram
Notary Public.

15-119-20102-0000

NW SW Section 5-33S-29W
Meade County, Kansas

RECEIVED
STATE CORPORATION COMMISSION

JUL 11 1972

CONSERVATION DIVISION
Wichita, Kansas

BOLIN NO. 1-5

CONTRACTORS: RINE DRILLING COMPANY, INC.

STARTED: June 20, 1972

COMPLETED: July 1, 1972

L O G

Sand	0 - 500'	
Red Bed	500' - 930'	Totco - 1/4° @ 521'
Sand & Red Bed	930' - 1555'	Totco - 1/2° @ 1005'
		Totco - 3/4° @ 1586'
Red Bed, Sand & Anhydrite	1555' - 1586'	Run 37 jts of 8 5/8" casing set @ 1585' Cement w/550 sx lt wt + 2% cc follow w/200 sx com. + 3% cc
Anhydrite	1586' - 2086'	
Shale	2086' - 2575'	
Shale & Anhydrite	2575' - 2725'	Totco - e/4° @ 2658'
Lime & Shale	2725' - 3385'	
Lime	3385' - 4640'	
Lime & Shale	4640' - 4860'	
Lime	4860' - 5850'	Totco - 1/2° @ 5008', 3/4° @ 5643'
Lime & Shale	5850' - 5900'	Totco - 3/4° @ 5900'
Lime	5900' - 5900'	TD Spot 35 sx, plus @ 1200' Spot 15 sx, plug @ 45' Spot 2 sx, plug RH & MH

STATE OF KANSAS)
COUNTY OF SEDGWICK) ss

I, R. M. Green, do hereby certify that the above is a true and accurate log of the BOLIN NO. 1-5. located NW SW Section 5-33S-29W, Meade County, Kansas.

R. M. Green
R. M. Green, Secretary-Treasurer

Subscribed and sworn to before me this 6th day of July, 1972.

T. W. Walker
T. W. Walker, Notary Public

