


Give All Information Completely  
Make Required Affidavit  
Mail or Deliver Report to:  
Conservation Division  
State Corporation Commission  
211 No. Broadway  
Wichita, Kansas

15-119-10077-0000

WELL PLUGGING RECORD

NORTH

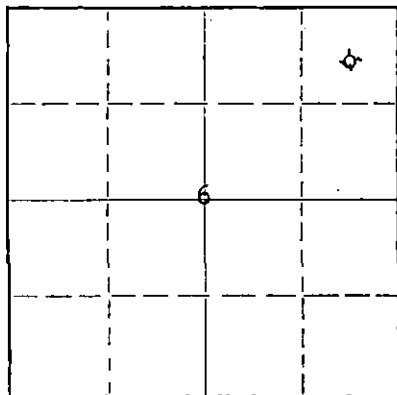

Locate well correctly on above  
Section Plat

Meade County, Sec. 6 Twp. 33S Rge. (E) 28 (W)  
Location as "NE/CNW/SW" or footage from lines C NE/4 NE/4  
Lease Owner Ferguson Oil Company  
Lease Name Harris Well No. 1  
Office Address 427 Union Center, Wichita, Kansas  
Character of Well (completed as Oil, Gas or Dry Hole) Dry Hole  
Date well completed December 26, 19 61  
Application for plugging filed January 9, 19 62  
Application for plugging approved verbal approval December 26, 19 61  
Plugging commenced December 26, 19 61  
Plugging completed 6 p.m. December 26, 19 61  
Reason for abandonment of well or producing formation DRY HOLE

If a producing well is abandoned, date of last production ----- 19  
Was permission obtained from the Conservation Division or its agents before plugging was commenced? Yes

Name of Conservation Agent who supervised plugging of this well Fred W. Hampel, Pretty Prairie, Kansas  
Producing formation none Depth to top --- Bottom --- Total Depth of Well 5640' Feet  
Show depth and thickness of all water, oil and gas formations.

OIL, GAS OR WATER RECORDS

CASING RECORD

| FORMATION | CONTENT | FROM | TO | SIZE   | PUT IN   | PULLED OUT |
|-----------|---------|------|----|--------|----------|------------|
|           |         |      |    | 8 5/8" | 1533.86' | none       |
|           |         |      |    |        |          |            |
|           |         |      |    |        |          |            |
Describe in detail the manner in which the well was plugged, indicating where the mud fluid was placed and the method or methods used in introducing it into the hole. If cement or other plugs were used, state the character of same and depth placed, from \_\_\_\_\_ feet to \_\_\_\_\_ feet for each plug set.

Filled hole with heavy mud to 500', set plug with 40 sax cement. Filled hole to 45' with heavy mud, set plug and cemented with 10 sax cement. Filled with heavy mud to top of hole with cement on top.

RECEIVED  
STATE CORP. COMMISSION  
JAN 1 1962  
1-10-1962  
CONSERVATION DIVISION  
Wichita, Kansas

(If additional description is necessary, use BACK of this sheet)

Name of Plugging Contractor Graham-Michaelis Drilling Company  
Address 211 North Broadway, Wichita 2, Kansas

STATE OF Kansas, COUNTY OF Sedgwick, ss.  
Muriel F. C. Jeram (employee of contractor) of the above-described well, being first duly sworn on oath, says: That I have knowledge of the facts, statements, and matters herein contained and the log of the above-described well as filed and that the same are true and correct. So help me God.

(Signature) Muriel F. C. Jeram  
Muriel F. C. Jeram  
211 North Broadway, Wichita 2, Kansas  
(Address)

SUBSCRIBED AND SWORN TO before me this 9th day of January, 19 62

My commission expires August 25, 1964

A. B. Barger  
Notary Public.



HARRIS #1

## WELL RECORD:

## LOCATION:

C NE NE Section 6-33S-28W  
Meade County, KansasCommenced: 12/5/61  
Completed: 12/27/61  
(Rotary)

## CONTRACTOR:

Graham-Michaelis Drilling Co.  
Liberal Division  
P. O. Box 896  
Liberal, Kansas

## CASING RECORD:

49 Joints 8-5/8" Casing  
Cemented w/550 sx Lite Wt.  
and 200 sx Common 2% cc

|                       | LOG         |
|-----------------------|-------------|
| Soil, Sand & Shale    | 0 - 555     |
| Sand, Salt & Shale    | 555 - 1240  |
| Sand, Shale & Gyp     | 1240 - 1440 |
| Shale & Anhy          | 1440 - 1585 |
| Red Bed, Shale & Clay | 1585 - 2341 |
| Shale & Lime          | 2341 - 3211 |
| Chalk                 | 3211 - 3491 |
| Chalky Lime & Shale   | 3491 - 3571 |
| Chalky Lime           | 3571 - 3745 |
| Chalky Lime & Shale   | 3745 - 3917 |
| Lime                  | 3917 - 3995 |
| Lime & Chalk          | 3995 - 4010 |
| Lime                  | 4010 - 4138 |
| Shale                 | 4138 - 4270 |
| Chalky Lime & Shale   | 4270 - 4463 |
| Lime & Shale          | 4463 - 4588 |
| Lime                  | 4588 - 5005 |
| Lime & Shale          | 5005 - 5055 |
| Lime                  | 5055 - 5102 |
| Lime & Shale          | 5102 - 5202 |
| Lime                  | 5202 - 5294 |
| Lime & Shale          | 5294 - 5308 |
| Lime                  | 5308 - 5577 |
| Lime, Shale & Sand    | 5577 - 5585 |
| Lime                  | 5585 - 5640 |

RECEIVED  
STATE CORPORATION COMMISSION


JAN 10 1962

CONSERVATION DIVISION  
Wichita, Kansas5640' - Total Rotary Depth

The undersigned, Graham-Michaelis Drilling Company, Liberal Division, certifies that the above log is a true and correct copy of the formations encountered in drilling the above mentioned well, as taken from the Daily Drilling Report.

GRAHAM-MICHAELIS DRILLING COMPANY  
LIBERAL DIVISION

By

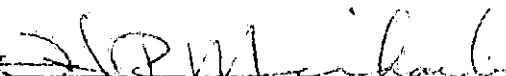  
H. R. Michaelis