


Give All Information Completely  
Make Required Affidavit  
Mail or Deliver Report to:  
Conservation Division  
State Corporation Commission  
211 No. Broadway  
Wichita, Kansas

WELL PLUGGING RECORD

NORTH

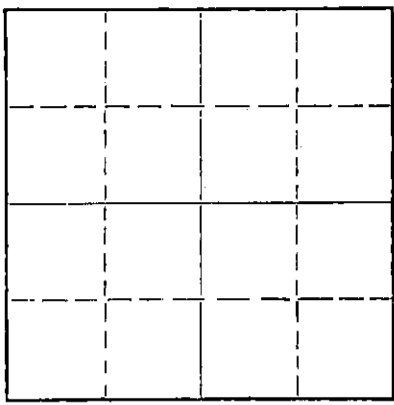

Locate well correctly on above  
Section Plat

Kingman County. Sec. 3 Twp. 30 Rge.        (E) 7 (W)  
Location as "NE/CNWSWK" or footage from lines C NE SE SW  
Lease Owner PICKRELL DRILLING COMPANY  
Lease Name Early "A" Well No. 2  
Office Address 705 4th Natl Bank Bldg, Wichita, Kansas  
Character of Well (completed as Oil, Gas or Dry Hole) Dry Hole  
Date well completed November 2, 19 63  
Application for plugging filed November 2, 19 63  
Application for plugging approved November 2, 19 63  
Plugging commenced November 2, 19 63  
Plugging completed November 2, 19 63  
Reason for abandonment of well or producing formation Dry Hole

If a producing well is abandoned, date of last production        19         
Was permission obtained from the Conservation Division or its agents before plugging was commenced? Yes

Name of Conservation Agent who supervised plugging of this well Fred Hampel  
Producing formation        Depth to top        Bottom        Total Depth of Well 4225 Feet  
Show depth and thickness of all water, oil and gas formations.

OIL, GAS OR WATER RECORDS

CASING RECORD

FORMATION	CONTENT	FROM	TO	SIZE	PUT IN	PULLED OUT
				8 5/8	200'	None

Describe in detail the manner in which the well was plugged, indicating where the mud fluid was placed and the method or methods used in introducing it into the hole. If cement or other plugs were used, state the character of same and depth placed, from        feet to        feet for each plug set.

Heavy mud to 225'. Set plug. Cemented with  
25 sacks cement. Heavy mud to 40'. Set plug.  
Cemented with 10 sacks cement to bottom of  
cellar. Plugged rat hole with 2 sacks cement.

RECEIVED  
STATE CORPORATION COMMISSION  
NOV 27 1963  
CONSERVATION DIVISION  
Wichita, Kansas

(If additional description is necessary, use BACK of this sheet)

Name of Plugging Contractor PICKRELL DRILLING COMPANY  
Address 705 4th National Bank Building, Wichita, Kansas

STATE OF KANSAS, COUNTY OF SEDGWICK, ss.  
C. W. SEBITS ~~NEPTHYNE PROSPECTOR~~ (owner or operator) of the above-described

well, being first duly sworn on oath, says: That I have knowledge of the facts, statements, and matters herein contained and the log of the above-described well as filed and that the same are true and correct. So help me God.

(Signature) C. W. SEBITS  
705 4th National Bank Building, Wichita, Kansas  
(Address)

SUBSCRIBED AND SWORN to before me this 7th day of November, 1963

Maxine Blackman  
Maxine Blackman  
Notary Public.

My commission expires June 21, 1966

15-095-01346-0000

ROTARY DRILLING LOG

COMPANY: PICKRELL DRILLING COMPANY  
705 4th Natl Bank Bldg.  
Wichita, Kansas  
LOCATION: EARLY "A" No. 2, NE SE SW Sec. 3-30-7W,  
Kingman County, Kansas

Rotary Drilling Commenced 10-22-63  
Rotary Drilling Completed 11-2-63

CONTRACTOR: PICKRELL DRILLING COMPANY  
Wichita, Kansas

CASING RECORD: (8 jts.) 8 5/8" surface casing set at 200', cemented with 150 sacks  
cement. Circulated. Completed 4:00 P.M. October 22, 1963. No oil  
string run, D & A.

LOG

(Figures indicate bottom of formation — measurements from top of rotary bushing.)

200	Red Rock	C. F. S.
1070	Red Rock, Shale & Shells	4155
1300	Shells & Lime	4165
1515	Shale & Lime	4173
1680	Lime	4180
3312	Lime & Shale	4190
3852	Lime	4200
4149	Lime & Shale	4205
4225	Mississippian - RTD	4225

Slope Tests

2450  
2975  
3525  
3950

S. L. M.

3594  
3852  
4117

RECEIVED  
STATE CORPORATION COMMISSION  
NOV 27 1963  
CONSERVATION DIVISION  
Wichita, Kansas

The undersigned, C. W. SEBITS, Attorney-in-Fact for PICKRELL DRILLING COMPANY, hereby certifies in behalf of said Company, that the above is a true and correct log of the formation encountered in drilling the above well as reflected by the Daily Drilling Reports.

PICKRELL DRILLING COMPANY

By C. W. SEBITS Attorney-in-Fact

STATE OF KANSAS }  
COUNTY OF SEDGWICK } ss.:

On this 7th day of November, 19 63, before me the undersigned, a Notary Public, in and for the County and State aforesaid, personally appeared C. W. SEBITS, to me known to be the identical person who subscribed the name of PICKRELL DRILLING COMPANY to the foregoing instrument as its Attorney-in-Fact and acknowledged to me that he executed the same as his free and voluntary act and deed, and as the free and voluntary act and deed of such company, for the uses and purposes therein set forth.

Given under my hand and seal of office the day and year last above written.

My commission expires: June 21, 1966

Maxine Blackman  
Maxine Blackman Notary Public