

15-095-01096-0000 R


STATE OF KANSAS  
STATE CORPORATION COMMISSION

Form CP-4

WELL PLUGGING RECORD

Give All Information Completely  
Make Required Affidavit  
Mail or Deliver Report to:  
Conservation Division  
State Corporation Commission  
212 No. Market  
Wichita, Kansas

Kingman County, Sec. 2 Twp. 30 Rge. 7 (E) (W)  
Location as "NE/CNW/SW" or footage from lines C NW SE SW  
Lease Owner H.C. Bennett  
Lease Name Wilson Well No. 2  
Office Address 1212 Union National Bldg. Wichita, Kansas  
Character of Well (completed as Oil, Gas or Dry Hole) Oil Well  
Date well completed 10-22-62 19  
Application for plugging filed 9-5-66 19  
Application for plugging approved 9-6-66 19  
Plugging commenced 9-6-66 19  
Plugging completed 9-9-66 19  
Reason for abandonment of well or producing formation depleted

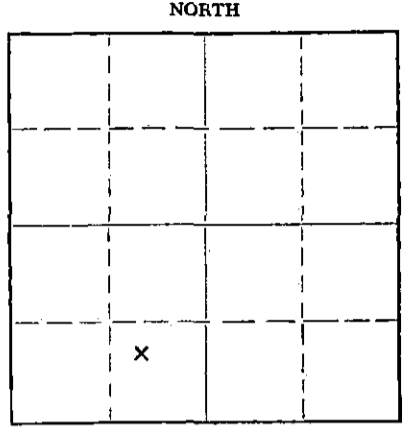

Locate well correctly on above Section Plat

If a producing well is abandoned, date of last production 19  
Was permission obtained from the Conservation Division or its agents before plugging was commenced? yes

Name of Conservation Agent who supervised plugging of this well Herman Justice  
Producing formation Depth to top Bottom Total Depth of Well 4255 Feet  
Show depth and thickness of all water, oil and gas formations.

OIL, GAS OR WATER RECORDS CASING RECORD

FORMATION	CONTENT	FROM	TO	SIZE	PUT IN	PULLED OUT
				8 5/8	210	none
				5 1/2	4255	3540'

Describe in detail the manner in which the well was plugged, indicating where the mud fluid was placed and the method or methods used in introducing it into the hole. If cement or other plugs were used, state the character of same and depth placed, from feet to feet for each plug set.

Fill hole with chat to 4150' and dump 5 sacks of cement  
Set 15' rock bridge from 411' to 396' and fill with mud to 200'  
Set 10' rock bridge from 200' to 190' and dump 25 sacks of cement  
Mud hole to 40', rock from 40' to 30' and dump 10 sacks of cement to surface

RECEIVED  
STATE CORPORATION COMMISSION  
SEP 14 1966  
9-14-66  
CONSERVATION DIVISION  
Wichita, Kansas

(If additional description is necessary, use BACK of this sheet)  
Name of Plugging Contractor Flint Engineering and Construction Co.  
Address 2375 W. Central El Dorado, Kansas

STATE OF Kansas, COUNTY OF Butler, ss.  
(employee of owner) or (owner or operator) of the above-described well, being first duly sworn on oath, says: That I have knowledge of the facts, statements, and matters herein contained and the log of the above-described well as filed and that the same are true and correct. So help me God.

(Signature) *Ronald P. Hanson*

(Address)

SUBSCRIBED AND SWORN to before me this 13 day of September 1966

My commission expires Sept. 27, 1967

*Ronald P. Hanson*  
Notary Public.

ROTARY DRILLING LOG

COMPANY: **PICKRELL DRILLING COMPANY**  
705 4th Natl. Bldg Wichita 2 Kansas

Rotary Drilling Commenced 10-10-62

Rotary Drilling Completed 10-22-62

LOCATION: **Wilson #2, C NW SE SW 2-30-7**  
Kingman County, Kansas

CONTRACTOR: **PICKRELL DRILLING COMPANY**  
Wichita, Kansas

CASING RECORD: (8 joints) 210' 8 5/8" Surface Casing set with 165 sacks cement.  
Circulated.

134 joints 5 1/2" Casing set at 4252.60' with 100 sacks cement.  
Completed at 9:15 A.M. 10-22-62.

LOG

(Figures indicate bottom of formation — measurements from top of rotary bushing.)

15	Sand	<u>C. F. S.</u>
210	Red Rock	4150
840	Red Rock & Shale	4160
1300	Shale & Shells	4165
1545	Lime & Shale	4170
1720	Lime	4180
1970	Lime & Shale	4190
3430	Lime	4200
3930	Lime & Shale	4235
4165	Mississippian	4255
4255	RTD - Mississippian	

Slope Test

2100  
3300  
4100

S. L. M.

2000  
2900  
3850

*open hole from 4252.60  
4255  
4162*

*Top - Surf -*

The undersigned, C. W. Sebitts, Attorney-in-Fact for PICKRELL DRILLING COMPANY, hereby certifies in behalf of said Company, that the above is a true and correct log of the formation encountered in drilling the above well as reflected by the Daily Drilling Reports.

PICKRELL DRILLING COMPANY

By *C. W. Sebitts*  
C. W. Sebitts Attorney-in-Fact

STATE OF KANSAS }  
COUNTY OF SEDGWICK } ss.:

On this 30th day of October, 1962, before me the undersigned, a Notary Public, in and for

the County and State aforesaid, personally appeared C. W. Sebitts, to me known to be the identical person who subscribed the name of PICKRELL DRILLING COMPANY to the foregoing instrument as its Attorney-in-Fact and acknowledged to me that he executed the same as his free and voluntary act and deed, and as the free and voluntary act and deed of such company, for the uses and purposes therein set forth.

Given under my hand and seal of office the day and year last above written.

*Maxine Blackman*  
Maxine Blackman Notary Public

My commission expires: 6-21-66