

15-095-01090-0000

RECEIVED
STATE CORPORATION COMMISSION

OCT 19 1972
10-19-72
CONSERVATION DIVISION
Wichita, Kansas


Form CP-4

STATE OF KANSAS
STATE CORPORATION COMMISSION

Give All Information Completely
Make Required Affidavit
Mail or Deliver Report to:
Conservation Division
State Corporation Commission
P. O. Box 17027
Wichita, Kansas 67217
NORTH

WELL PLUGGING RECORD

Kingman County, Sec. 1 Twp. 30 Rge. 7 (E) W (W)
Location as "NE/CNWSW" or footage from lines NW SW NE
Lease Owner Pickfell Drilling Company
Lease Name Maple 'C' Well No. #1
Office Address 705 Fourth Nat'l Bank Bldg.; Wichita, Ks. 67202
Character of Well (completed as Oil, Gas or Dry Hole) Oil
Date well completed December 18 1960
Application for plugging filed Sept. 27 1972
Application for plugging approved Sept. 28 1972
Plugging commenced Sept. 28 1972
Plugging completed Oct. 3 1972
Reason for abandonment of well or producing formation Well Depleted

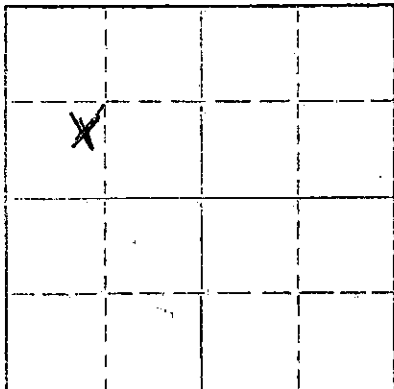

Locate well correctly on above Section Plat

If a producing well is abandoned, date of last production Sept. 26 1972
Was permission obtained from the Conservation Division or its agents before plugging was commenced? Yes

Name of Conservation Agent who supervised plugging of this well Russell Biberstein
Producing formation Miss. Chat Depth to top 4089 Bottom 4154 Total Depth of Well 4181 Feet
Show depth and thickness of all water, oil and gas formations.

OIL, GAS OR WATER RECORDS

CASING RECORD

FORMATION	CONTENT	FROM	TO	SIZE	PUT IN	PULLED OUT
				8 5/8"	242	None
				5 1/2"	4181	3300

Describe in detail the manner in which the well was plugged, indicating where the mud fluid was placed and the method or methods used in introducing it into the hole. If cement or other plugs were used, state the character of same and depth placed, from _____ feet to _____ feet for each plug set.

Sept. 28, 1972 Plugged off bottom. Dumped sand to 4050'. Mixed and dumped 5 sx of cement.
Oct. 3, 1972 Plugged off top. Set 10' rock bridge at 240'. Filled 8 5/8" surface casing from 240' to base of cellar with 3000 lb. P.S.I. ready mix concrete.

(If additional description is necessary, use BACK of this sheet)

Name of Plugging Contractor RUSS CASING PULLING, INC.
Address P. O. Box 1082 ; Great Bend, Kansas 67530


STATE OF Kansas COUNTY OF Sedgwick, ss.
Dale M. Robinson (employee of owner) or (owner or operator) of the above-described

well, being first duly sworn on oath, says: That I have knowledge of the facts, statements, and matters herein contained and the log of the above-described well as filed and that the same are true and correct. So help me God.

(Signature) Dale M. Robinson
705 Fourth National Bank Bldg., Wichita, Kansas
(Address)

Subscribed and sworn to before me this 18th day of October, 1972.

My commission expires January 19, 1973
Esther Lamone
Esther Lamone Notary Public.

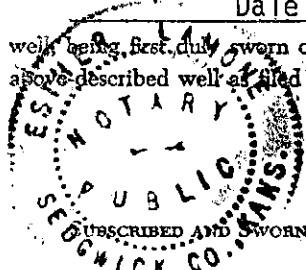

15-095-01090-0000

ROTARY DRILLING LOG

COMPANY: Pickrell Drilling Company
705 Fourth National Bank Building
Wichita, Kansas
LOCATION: Maple "C" #1 NW SW NE Sec. 1-30S-7W
Kingman County, Kansas

Rotary Drilling Commenced 11-7-60
Rotary Drilling Completed 11-20-60

CONTRACTOR: **PICKRELL DRILLING COMPANY**
Wichita, Kansas

CASING RECORD: Ran 6 jts. 8 5/8" 17.3# Spiralweld csg. Set @ 242; w/165 sks. Circ.
Ran 131 jts. 5 1/2" O.D. 14# csg. Set @ 4181' w/ 90 sks cement.

LOG

(Figures indicate bottom of formation — measurements from top of rotary bushing.)

35	Sand		<u>Circulate for Samples</u>
150	Red Beds		
370	Red Beds, shale	4090	
825	Shale, shells	4105	
995	Salt, shale, shells	4108	
1030	Anhydrite	4123	
1290	Lime, shale	4133	
1700	Lime	4143	
3030	Lime, shale	4148	
3170	Sand, lime, shale	4180	
3280	Shale, sand, lime		<u>Slope Test</u>
3580	Lime, shale		
3875	Lime	1500'	0°
4075	Shale, lime	2000'	0°
4087	Lime, shale	3500'	0°
4180	Miss. T.D.	4100'	0°

S.L.M.

240' OK
1200' OK
2500' OK
3800' OK
4180' OK

RECEIVED
STATE CORPORATION COMMISSION
SEP 28 1972
CONSERVATION DIVISION
Wichita, Kansas

The undersigned, C. W. Sebitts, Attorney-in-Fact for PICKRELL DRILLING COMPANY, hereby certifies in behalf of said Company, that the above is a true and correct log of the formation encountered in drilling the above well as reflected by the Daily Drilling Reports.

PICKRELL DRILLING COMPANY
By C. W. Sebitts
Attorney-in-Fact

STATE OF KANSAS }
COUNTY OF SEDGWICK } ss.:

On this 28th day of November, 19 60, before me the undersigned, a Notary Public, in and for the County and State aforesaid, personally appeared C. W. Sebitts, to me known to be the identical person who subscribed the name of PICKRELL DRILLING COMPANY to the foregoing instrument as its Attorney-in-Fact and acknowledged to me that he executed the same as his free and voluntary act and deed, and as the free and voluntary act and deed of such company, for the uses and purposes therein set forth.

Given under my hand and seal of office the day and year last above written.

My commission expires: March 7, 1964

Marilyn A. Davis
Notary Public
Marilyn A. Davis