

STATE OF KANSAS
STATE CORPORATION COMMISSION
CONSERVATION DIVISION
200 Colorado Derby Building
Wichita, Kansas 67202

RECEIVED
KANSAS CORPORATION COMMISSION
FORM CP-1
Rev. 2/89

SEP 11 1991

CONSERVATION DIVISION
WICHITA, KS

WELL PLUGGING APPLICATION FORM
(File One Copy)

API NUMBER 150252036800 (of this well).

(This must be listed; if no API# was issued, please note drilling completion date.)

WELL OWNER/OPERATOR MESA OPERATING LTD. PARTNERSHIP OPERATOR'S LICENSE NO. 04824 2-92

ADDRESS P.O. BOX 2009 AMARILLO TX 79189 PHONE # (806) 378-1000

LEASE (FARM) SCHEIB WELL NO. #1 WELL LOCATION 2130' FSL/560' COUNTY CLARK

SEC. 18 TWP. 31S RGE. 21W (E) or (W) TOTAL DEPTH 5350' PLUG BACK TO

Check One:

OIL WELL GAS WELL X D & A SWD or INJ WELL DOCKET NO.

SURFACE CASING SIZE 8-5/8" SET AT 664' CEMENTED WITH 350 SACKS

CASING SIZE SET AT CEMENTED WITH SACKS

PERFORATED AT 5183' - 5199'

CONDITION OF WELL: GOOD X POOR CASING LEAK JUNK IN HOLE

PROPOSED METHOD OF PLUGGING SPOT 30 SX CMT PLUG 4705'-5100'. DOWN 4-1/2" CASING, CUT OFF 4-1/2" CASING @ ± 3000', SPOT 40 SX CMT PLUG @ CUT OFF POINT, PULL 4-1/2" CASING TO 1100' AND SPOT 50 SX CMT PLUG, PULL 4-1/2" CASING TO 700' AND SPOT 50 SX CMT PLUG, PULL 4-1/2" CASING TO
(If additional space is needed use back of form.) (OVER)

IS WELL LOG ATTACHED TO THIS APPLICATION AS REQUIRED? ON FILE IS ACO-1 FILED? YES
(If not explain.)

DATE AND HOUR PLUGGING IS DESIRED TO BEGIN SEPT. 23, 1991 5 A.M.

PLUGGING OF THIS WELL WILL BE DONE IN ACCORDANCE WITH K.S.A. 55-101 et. seq. AND THE RULES AND REGULATIONS OF THE STATE CORPORATION COMMISSION.

NAME OF REPRESENTATIVE AUTHORIZED TO BE IN CHARGE OF PLUGGING OPERATIONS:

BILL McELYA PHONE # (806) 378-4872

ADDRESS P.O. BOX 2009 AMARILLO TX 79189

PLUGGING CONTRACTOR SARGENTS CASING PULLERS LICENSE NO. 6547 6-82

ADDRESS 620 S. LINCOLN LIBERAL KS 67901 PHONE # (316) 624-7455

PAYMENT OF THE PLUGGING FEE (K.A.R. 82-3-118) WILL BE GUARANTEED BY OPERATOR OR AGENT.

VERBAL PLUGGING INSTRUCTIONS PER
GLENN BARLOW OF KCC (316) 225-6760

SIGNED: *Deana R. Pegg*
(Operator or Agent)

DATE: 9-10-91

REVERSE SIDE OF ORIGINAL COPY

100 11-130

PROPOSED METHOD OF PLUGGING

PROPOSED METHOD OF PLUGGING

40' AND SPOT 10 SX CMT PLUG, CUT OFF 8-5/8" CASING 3' BGL, WELD ON TRASH CAP.
9.0 PPG 36 SEC/QT VIS MUD BETWEEN PLUGS.


15-025-20368.0000

SPUD DATE 5-16-80

KB. 2144

COMP DATE 6-17-80

GL. 2139

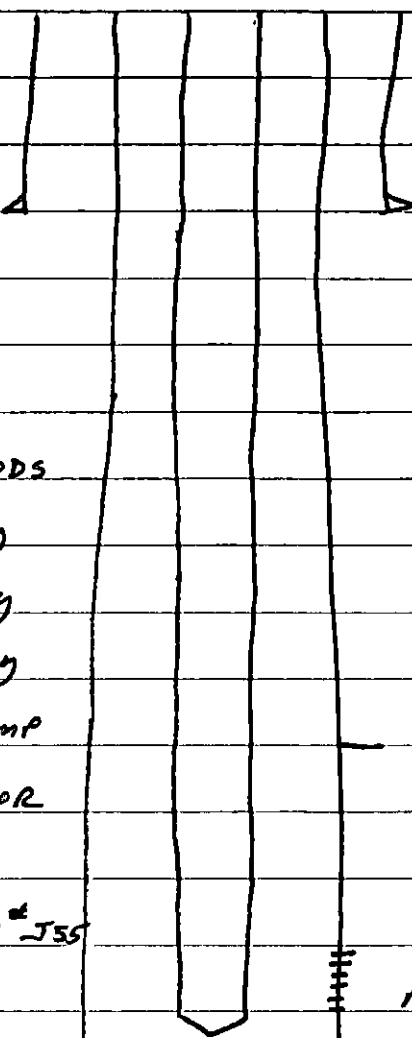

8 5/8" @ 664' w/ 350 psi
CIRC.

ROD STRING - 205 - 5/8" RODS

1- 8' x 5/8" PONY

1- 4' x 5/8" PONY

2- 2' x 5/8" PONY

2" x 1 1/2" x 14' PUMP

5' GAS ANCHOR

TOC 4680' BY CBL

TUBING STRING - 172 JTS 2 3/8 4.7" J55

1- 10' PUP

1- 6' PUP

1- 4' PUP

1 25/32" SEATING NIPPLE

3' PERF SUB

20' MUD ANCHOR

MORROW PERFS 5183-5199

TUBING SET @ 5195'

4 1/2" 10.5" @ 5275' w/

VERBAL PLUGGING INSTRUCTIONS PER GLENN BARLOW W/KCC (316) 225-6760

RECEIVED
KANSAS CORPORATION COMMISSION

SEP 11 1991

CONSERVATION DIVISION
WICHITA, KS

Joan Finney
Governor

Jim Robinson
Chairman

Keith R. Henley
Commissioner

Rachel C. Lipman
Commissioner

Judith McConnell
Executive Director

Brian J. Moline
General Counsel



Kansas Corporation Commission

NOTICE OF RECEIPT OF WELL PLUGGING APPLICATION

SEPTEMBER 12, 1991

Mesa Operating LTD, Partnership
P. O. Box 2009
Amarillo, TX 79189

Scheib #1
2130' FSL - 560' FEL
Sec. 18-31S-21W
Clark County, Kansas
API #15-025-20,368-~~0000~~

Dear Operator:


This letter is to notify you that the Conservation Division is in receipt of your plugging proposal, form CP-1, for the above-captioned well.

Your CP-1 has been reviewed by the Conservation Division central office for completeness and to verify license numbers. The plugging proposal will now be forwarded to the district office listed below for review of your proposed method of plugging. Please contact the district office to review your proposed plugging method at least five (5) days before plugging the well, pursuant to K.A.R. 82-3-113(b). Failure to do so is punishable by an administrative penalty of up to \$1000.

It has recently come to my attention that the form CP-1 has been filed by operators other than the owner or operator of the well and without the consent of the owner or operator. The Conservation Division's review of form CP-1, either in the central or district office, does not include an inquiry into well ownership or the filing operator's legal right to plug the well. The CP-1 is simply reviewed to determine compliance with plugging rules and regulations.

This notice in no way constitutes authorization to plug the above-captioned well by persons not having legal rights of ownership or interest in the well. This notice is void after ninety (90) days from the above date.

Sincerely,


David P. Williams
Production Supervisor

District #1
304 W. McArtor
Dodge City, KS 67801
(316) 225-67801

Conservation Division
William R. Bryson
Director
200 Colorado Derby Bldg.
202 W. 1st Street
Wichita, Kansas 67202-1286
Telephone (316) 263-3238