

This form shall be filed in duplicate with the Kansas Corporation Commission, 200 Colorado Derby Building, Wichita, Kansas 67202, within ten days after the completion of the well, regardless of how the well was completed.

Attach separate letter of request if the information is to be held confidential. If confidential, only file one copy. Information on side one will be of public record and side two will then be held confidential.

Circle one: Oil, Gas, Dry, SWD, OWWO, Injection. Type and complete ALL sections.

Applications must be filed for dual completion, commingling, SWD and injection, T.A.

Attach wireline logs (i.e. electrical log, sonic log, gamma ray neutron log, etc.).

KCC # (316) 263-3238. (Rules 82-2-105 & 82-2-125)

OPERATOR Seagull Operating Company

API NO. 15-025-20761-00-00

ADDRESS 1215 Mid-South Towers

COUNTY Clark

Shreveport, Louisiana 71101

FIELD McKinney

**CONTACT PERSON Warren E. Richardson

PROD. FORMATION None

PHONE 316 775 3613

LEASE Theis "A"

PURCHASER

WELL NO. 1

ADDRESS

WELL LOCATION C NW 1/4 Sec. 27

DRILLING Aldebaran Drilling Company

1320 Ft. from North Line and

CONTRACTOR

1320 Ft. from West Line of

ADDRESS 453 S. Webb Road, Suite 100

the SEC. 27 TWP. 34 RGE. 25

Wichita, Kansas 67207


WELL PLAT

PLUGGING Aldebaran Drilling Company

CONTRACTOR

ADDRESS 453 S. Webb Road, Suite 100

Wichita, Kansas 67207

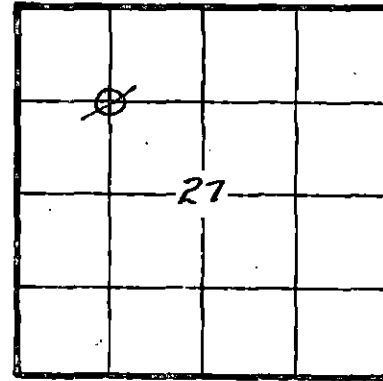

KCC [checked]
KGS [checked]
(Office Use)

TOTAL DEPTH 5860 PBDT Surface

SPUD DATE 1-3-84 DATE COMPLETED 1-14-84

ELEV: GR 2026 DF 2027 KB 2028

DRILLED WITH (CABLE) (ROTARY) (AIR) TOOLS

Amount of surface pipe set and cemented 889 DV Tool Used? No

AFFIDAVIT

STATE OF Kansas, COUNTY OF Butler SS, I,

Warren E. Richardson OF LAWFUL AGE, BEING FIRST DULY SWORN UPON HIS OATH,

DEPOSES THAT HE IS representative (FOR)(OF) Seagull Operating Company

OPERATOR OF THE Theis "A" LEASE, AND IS DULY AUTHORIZED TO MAKE

THIS AFFIDAVIT FOR AND ON THE BEHALF OF SAID OPERATOR, THAT WELL NO. 1 ON

SAID LEASE HAS BEEN COMPLETED AS OF THE 15th DAY OF January, 19 84, AND THAT

ALL INFORMATION ENTERED HEREIN WITH RESPECT TO SAID WELL IS TRUE AND CORRECT.

FURTHER AFFIANT SAITH NOT.

(S) Warren E. Richardson

SUBSCRIBED AND SWORN BEFORE ME THIS 31st DAY OF January, 19 84.

E. James Richardson
NOTARY PUBLIC

MY COMMISSION EXPIRES: 5-19-86

**The person who can be reached by phone regarding any questions concerning this information. Within 45 days of completion, a witnessed initial test by the Commission is required if the well produces more than 25 BOPD or is located in a Basic Order P...

RECEIVED
STATE CORPORATION COMMISSION
FEB 17 1984
OBSERVATION DIVISION
Wichita, Kansas

WELL LOG

Show all important zones of porosity and contents thereof; corrod intervals, and all drill-stem tests, including depth interval tested, cushion used, time tool open, flowing and shut-in pressures, and recoveries.

SHOW GEOLOGICAL MARKERS, LOGS RUN, OR OTHER DESCRIPTIVE INFORMATION.

FORMATION DESCRIPTION, CONTENTS, ETC.	TOP	BOTTOM	NAME	DEPTH
			Chase	2393
			Wabaunsee	3436
			Heebner	4328
			Lansing	4504
			Stark Sh.	5046
			Cherokee Sh.	5354
			Morrow Sh.	5630
			Mississippi	5683
<p>Plug # 1 70 sks @ 1020'</p> <p>Plug # 2 40 sks @ 510'</p> <p>Plug # 3 10 sks @ 40'</p> <p>Plug # 4 15 sks in rathole</p> <p>Plug # 5 10 sks in mousehole</p> <p>Plug # 6 5 sks in water well</p>				

Report of all strings set — surface, intermediate, production, etc. CASING RECORD (New) or (Used)

Purpose of string	Size hole drilled	Size casing set (in O.D.)	Weight lbs/ft.	Setting depth	Type cement	Sacks	Type and percent additives
Conductor	24	16"	75	100	Redi-Mix	260	2% CaCl
Surface	12½	8 5/8	24	889	Common	500	2% gel 3% CaCl

LINER RECORD

PERFORATION RECORD

Top, ft.	Bottom, ft.	Sacks cement	Shots per ft.	Size & type	Depth interval

TUBING RECORD		
Size	Setting depth	Packer set at

ACID, FRACTURE, SHOT, CEMENT SQUEEZE RECORD

Amount and kind of material used	Depth interval treated

Date of first production	Producing method (flowing, pumping, gas lift, etc.)	Gravity
RATE OF PRODUCTION PER 24 HOURS	Oil bbls.	Gas MCF
	Water %	Gas-oil ratio CFPB
Disposition of gas (vented, used on lease or sold)		Perforations