

ORIGINAL

SIDE ONE

STATE CORPORATION COMMISSION OF KANSAS
OIL & GAS CONSERVATION DIVISION
RECOMPLETION FORM
ACO-2 AMENDMENT TO WELL HISTORY

API NO. 15- 189-21218-A00-01

County STEVENS

S/2 NE sec. 17 Twp. 33S Rge. 38 X East West

3293.5 Ft. North from Southeast Corner of Section

1390 Ft. West from Southeast Corner of Section
(NOTE: Locate well in section plat below.)

Lease Name WAGNER #1 UNIT Well # 3

Field Name HUGOTON

Producing Formation CHASE

Elevation: Ground 3170 KB 3186

Operator: License # 5208

Name: MOBIL OIL CORPORATION

Address: 3219 NORTH KANSAS

City/State/Zip: LIBERAL, KS 67901

Purchaser:
SPOT MARKET

Operator Contact Person:
Phone: (316) 626-1160 RAE KELLY

Designate Type of Original Completion
 New Well Re-Entry X Workover

Date of Original Completion ST. LOUIS

Name of Original Operator MOBIL OIL CORPORATION

Original Well Name WAGNER #1 UNIT WELL #3


Date of Recompletion:
12/9/89 1/4/90
Commenced Completed

Re-entry Workover

Designate Type of Recompletion/Workover:
X Oil SWD Temp. Abd.
X Gas Inj Delayed Comp.
 Dry Other (Core, Water Supply, etc.)

X Deepening Re-perforation
X Plug Back 3096 PBTB
 Conversion to Injection/Disposal

Is recompleted production:
 Commingled Docket No.
 Dual Completion Docket No.
 Other (Disposal or Injection?)
Docket No.

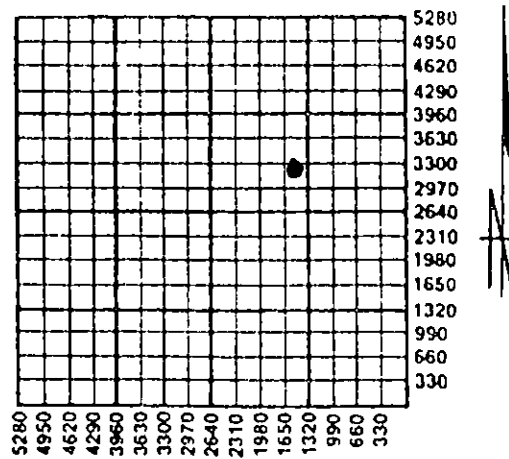

K.C.C. OFFICE USE ONLY
F Letter of Confidentiality Attached
C Wireline Log Received
C Drillers Timelog Received
Distribution
X KCC SWD/Rep NGPA
 KGS Plug Other
(Specify)


INSTRUCTIONS: This form shall be completed in triplicate and filed with the Kansas Corporation Commission, 200 Colorado Derby Building, Wichita, Kansas 67202, within 120 days of the recompletion of any well. Rules 82-3-107 and 82-3-141 apply. Information on side two of this form will be held confidential for a period of 12 months if requested in writing and submitted with the form. See rule 82-3-107 for confidentiality in excess of 12 months. One copy of any additional wireline logs and driller's time logs (not previously submitted) shall be attached with this form. Submit ACO-4 or ACO-5 prior to or with this form for approval of commingling or dual completions. Submit CP-1 with all plugged wells. Submit CP-111 with all temporarily abandoned wells. NOTE: Conversion of wells to either disposal or injection must receive approval before use; submit form U-1.

All requirements of the statutes, rules and regulations promulgated to regulate the oil and gas industry have been fully complied with and the statements herein are complete and correct to the best of my knowledge.

Signature R. Kelly Title ENGINEERING TECHNICIAN Date 10-5-90

Subscribed and sworn to before me this 5th day of October 1990

Notary Public Edith L. Cunningham Date Commission Expires November 8, 1991

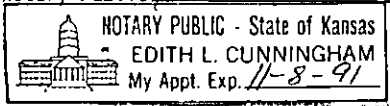

CONSERVATION DIVISION
Wichita, Kansas

FORM ACO-2
7/89

RECEIVED
STATE CORPORATION COMMISSION
OCT 10 1990

SIDE TWO

Operator Name MOBIL OIL CORPORATION Lease Name WAGNER #1 UNIT Well # 3
 Sec. 17 Twp. 33s Rge. 38 East West
 County STEVENS

RECOMPLETION FORMATION DESCRIPTION

Log Sample

Name	Top	Bottom
CHASE	2490	
COUNCIL GROVE	2794	
WABAUNSEE	3242	
LANSING	4147	
KANSAS CITY	4508	
MORROW	5644	
CHESTER	6132	
ST. LOUIS	6364	

ADDITIONAL CEMENTING/SQUEEZE RECORD

Purpose: <input type="checkbox"/> Perforate <input type="checkbox"/> Protect Casing <input type="checkbox"/> Plug Back TD <input type="checkbox"/> Plug Off Zone	Depth		Type of Cement	# Sacks Used	Type and Percent Additives
	Top	Bottom			

Shots Per Foot	PERFORATION RECORD Specify Footage of Each Interval Perforated	Acid, Fracture, Shot, Cement Squeeze Record (Amount and Kind of Material Used)
5	2466 - 2489	ACIDIZED W/3100 GAL 15% HCL
9	2490 - 2550	
7	2563 - 2600	FRAC'D W/84,462 GELLED FLUID
7	2626 - 2670	W299.838 LBS SAND
3	2688 - 2700	

PBTD 3096 Plug Type CEMENT

TUBING RECORD

Size NA Set At NA Packer At NONE Was Liner Run Y N

Date of Resumed Production, Disposal or Injection 8/6/90 DATE OF FIRST PRODUCTION

Estimated Production Per 24 Hours Oil _____ Bbls. Water _____ Bbls. Gas-Oil-Ratio
 Gas 715.4 Mcf

Disposition of Gas:
 Vented Sold Used on Lease (If vented, submit ACO-18.)