

STATE CORPORATION COMMISSION OF KANSAS
OIL & GAS CONSERVATION DIVISION
WELL COMPLETION OR RECOMPLETION FORM
ACO-1 WELL HISTORY
DESCRIPTION OF WELL AND LEASE

Operator: License # 4549
Name Anadarko Petroleum Corporation
Address P. O. Box 351
City/State/Zip Liberal, Kansas 67905-0351

Purchaser Panhandle Eastern Pipe Line Co.

Operator Contact Person M. L. Pease
Phone (316) 624-6253

Contractor: License # 5842
Name Gabbert-Jones, Inc.

Wellsite Geologist Mark Smith
Phone (406) 487-2802

Designate Type of Completion
 New Well Re-Entry Workover
 Oil SWD Temp Abd
 Gas Inj Delayed Comp.
 Dry Other (Core, Water Supply etc.)

If OWMO: old well info as follows:
Operator
Well Name
Comp. Date
Old Total Depth

WELL HISTORY

Drilling Method:
 Mud Rotary Air Rotary Cable
9-10-88 9-20-88 10-2-88
Spud Date Date Reached TD Completion Date
5800 5240
Total Depth PBTD

Amount of Surface Pipe Set and Cemented at 1476 feet
Multiple Stage Cementing Collar Used? Yes No
If yes, show depth set 2558 feet
If alternate 2 completion, cement circulated
from _____ feet depth to _____ w/ _____ SX cmt
Cement Company Name Halliburton Services
Invoice # 720831

API NO. 15-129-20,931-00-00
County Morton
NE Sec. 3 Twp. 33S Rge. 40 East
West

4030 Ft North from Southeast Corner of Section
1487 Ft West from Southeast Corner of Section
(Note: Locate well in section plat below)


Lease Name USA "I" Well # 1

Field Name Stirrup

Producing Formation U. Morrow D.

Elevation: Ground 3215' KB 3227'

Section Plat

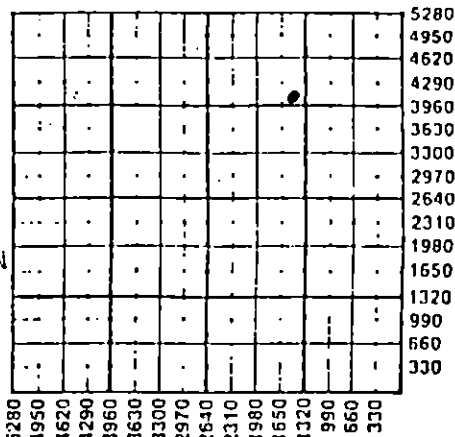

RECEIVED
10-10-89
OCT 10 1989

CONSERVATION DIVISION
Wichita, Kansas

WATER SUPPLY INFORMATION

Disposition of Produced Water: Disposal
Docket # Repressuring

Questions on this portion of the ACO-1 call:
Water Resources Board (913) 296-3717

Source of Water:
Division of Water Resources Permit #

Groundwater _____ Ft North from Southeast Corner
(Well) _____ Ft West from Southeast Corner of
Sec Twp Rge East West

Surface Water _____ Ft North from Southeast Corner
(Stream, pond etc) _____ Ft West from Southeast Corner
Sec Twp Rge East West

Other (explain) Contractor furnished water
(purchased from city, R.W.D. #)

INSTRUCTIONS: This form shall be completed in triplicate and filed with the Kansas Corporation Commission, 200 Colorado Derby Building, Wichita, Kansas 67202, within 120 days of the spud date of any well. Rule 82-3-130, 82-3-107 and 82-3-106 apply.

Information on side two of this form will be held confidential for a period of 12 months if requested in writing and submitted with the form. See rule 82-3-107 for confidentiality in excess of 12 months. One copy of all wireline logs and drillers time log shall be attached with this form. Submit CP-4 form with all plugged wells. Submit CP-111 form with all temporarily abandoned wells.

All requirements of the statutes, rules and regulations promulgated to regulate the oil and gas industry have been fully complied with and the statements herein are complete and correct to the best of my knowledge.

Signature M. L. Pease
Title Division Production Manager Date 10/16/89

Subscribed and sworn to before me this 17th day of October 1989
Notary Public

Date Commission Expires

K.C.C. OFFICE USE ONLY
 Letter of Confidentiality Attached
 Wireline Log Received
 Drillers Timelog Received
Distribution
 KCC SWD/Rap NGPA
 KGS Plug Other
(Specify)
10-10-88

MY APPL. EXPIRES 7-6-91

Sec 3, Twp 33, Rge 40