

STATE CORPORATION COMMISSION OF KANSAS
OIL & GAS CONSERVATION DIVISION
WELL COMPLETION OR RECOMPLETION FORM
ACO-1 WELL HISTORY
DESCRIPTION OF WELL AND LEASE

Operator: License # 5399
Name AMERICAN ENERGIES CORPORATION
Address 575 Fourth Financial Center
Wichita, KS 67202
City/State/Zip

Purchaser N/A

Operator Contact Person Alan L. DeGood
Phone 316-263-5785

Contractor: License # 5131
Name Thunderbird Drilling

Wellsite Geologist Steve Davis
Phone 316-267-9115

Designate Type of Completion
New Well Re-Entry Workover
Oil SWD Temp Abd
Gas Inj Delayed Comp.
X Dry Other (Core, Water Supply etc.)

If CWMO: old well Info as follows:
Operator
Well Name
Comp. Date Old Total Depth

WELL HISTORY


Drilling Method:
XX Mud Rotary Air Rotary Cable
3/4/86 3/15/86 N/A 3-15-86
Spud Date Date Reached TD Completion Date
4605 NA
Total Depth PBDT

Amount of Surface Pipe Set and Cemented at 256 feet
Multiple Stage Cementing Collar Used? Yes XX No
If yes, show depth set
If alternate 2 completion, cement circulated from feet depth to w/SX cmt
Cement Company Name
Invoice #

API NO. 15-095-21,553-0000
County Kingman
C... NE SW Sec. 5 Twp. 30 Rge. 5 XX East West
1980 Ft North from Southeast Corner of Section
3300 Ft West from Southeast Corner of Section
(Note: Locate well in section plat below)

Lease Name Kimberlin "B" Well # 1
Field Name WC
Producing Formation na
Elevation: Ground 1481 KB 1486

Section Plat

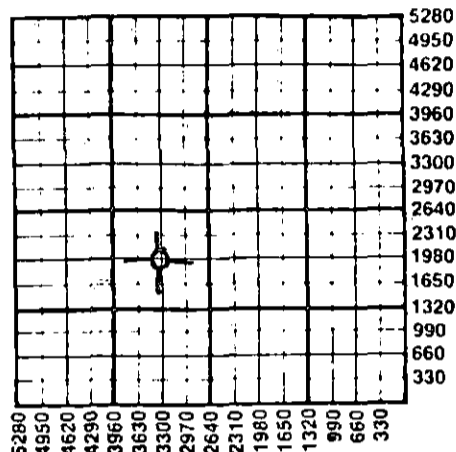

WATER SUPPLY INFORMATION

Disposition of Produced Water: Disposal
Docket # Repressuring

Questions on this portion of the ACO-1 call:

Water Resources Board (913) 296-3717

Source of Water:
Division of Water Resources Permit #
Groundwater Ft North from Southeast Corner (Well) Ft West from Southeast Corner of Sec Twp Rge East West
Surface Water Ft North from Southeast Corner (Stream, pond etc) Ft West from Southeast Corner Sec Twp Rge East West
Other (explain) Mr. Harry Dick, Norwalk, KS (purchased from city, R.W.D. #)

INSTRUCTIONS: This form shall be completed in duplicate and filed with the Kansas Corporation Commission, 200 Colorado Derby Building, Wichita, Kansas 67202, within 90 days after completion or recompletion of any well. Rule 82-3-130 and 82-3-107 apply.

Information on side two of this form will be held confidential for a period of 12 months if requested in writing and submitted with the form. See rule 82-3-107 for confidentiality in excess of 12 months. One copy of all wireline logs and drillers time log shall be attached with this form. Submit CP-4 form with all plugged wells. Submit CP-111 form with all temporarily abandoned wells.

All requirements of the statutes, rules and regulations promulgated to regulate the oil and gas industry have been fully complied with and the statements herein are complete and correct to the best of my knowledge.

Signature Alan L. DeGood
Title Vice President Date 4/4/86

Subscribed and sworn to before me this 4th day of April 1986.
Notary Public LuAnn Hershorn
Date Commission Expires August 29, 1988



APR = 7 1986
CONSERVATION DIVISION
Wichita, Kansas

K.C.C. OFFICE USE ONLY
Letter of Confidentiality Attached
Wireline Log Received
Drillers Timelog Received
Distribution
KCC SWD/Rap NGPA
KGS Plug Other
(Specify)

Sec 5 Twp 30 Rge 5 W