

ORIGINAL

SIDE ONE

STATE CORPORATION COMMISSION OF KANSAS  
OIL & GAS CONSERVATION DIVISION  
RECOMPLETION FORM  
ACO-2 AMENDMENT TO WELL HISTORY

Operator: License # 8996

Name: Mid Continent Resources

Address: P. O. Box 399

City/State/Zip: Garden City, KS  
67846

Purchaser: None

Operator Contact Person: Michael J. Wreath  
Phone: (316) 275-2963

Designate Type of Original Completion  
 New Well  Re-Entry  Workover

Date of Original Completion July 28, 1985

Name of Original Operator Mid Continent Resources

Original Well Name Cotton 2C-85

Date of Recompletion:  
July 21, 1991 July 22, 1991

Commenced  Completed

Re-entry  Workover

Designate Type of Recompletion/Workover:  
 Oil  SWD  Temp. Abd.  
 Gas  Inj  Delayed Comp.  
 Dry  Other (Core, Water Supply, etc.)  
 Deepening  Re-perforation  
 Plug Back  PBTD  
 Conversion to Injection/Disposal

Is recompleted production:  
 Commingled Docket No. \_\_\_\_\_  
 Dual Completion Docket No. \_\_\_\_\_  
 Other (Disposal or Injection?)  
Docket No. E-26,300

API NO. 15- 175-20,865-0001

County Seward

SW   NW   NW   Sec. 6 Twp. 32 Rge. 32  East West

4290 Ft. North from Southeast Corner of Section

4950 Ft. West from Southeast Corner of Section


(NOTE: Locate well in section plat below.)

Lease Name Cotton Well # 2C-85

Field Name Shamrock

Producing Formation None-Injection only

Elevation: Ground 2859 KB 2870

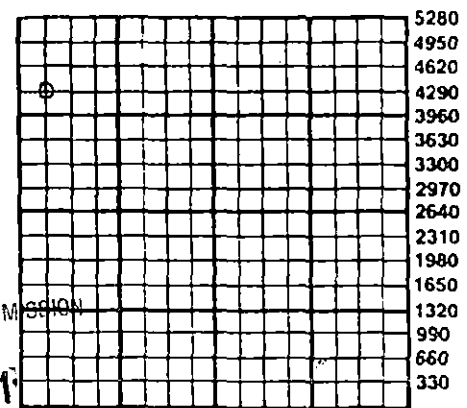

RECEIVED  
8-19-91  
AUG 19 1991  
STATE CORPORATION COMMISSION  
Wichita, Kansas

K.C.C. OFFICE USE ONLY  
F  Letter of Confidentiality Attached  
C  Wireline Log Received  
C  Drillers Timelog Received  
Distribution  
 KCC  SWD/Rep  NGPA  
 KGS  Plug  Other (Specify)

INSTRUCTIONS: This form shall be completed in triplicate and filed with the Kansas Corporation Commission, 200 Colorado Derby Building, Wichita, Kansas 67202, within 120 days of the recompletion of any well. Rules 82-3-107 and 82-3-141 apply. Information on side two of this form will be held confidential for a period of 12 months if requested in writing and submitted with the form. See rule 82-3-107 for confidentiality in excess of 12 months. One copy of any additional wireline logs and driller's time logs (not previously submitted) shall be attached with this form. Submit ACO-4 or ACO-5 prior to or with this form for approval of commingling or dual completions. Submit CP-1 with all plugged wells. Submit CP-111 with all temporarily abandoned wells. NOTE: Conversion of wells to either disposal or injection must receive approval before use; submit form U-1.

All requirements of the statutes, rules and regulations promulgated to regulate the oil and gas industry have been fully complied with and the statements herein are complete and correct to the best of my knowledge.

Signature Michael J. Wreath Title Company Geologist Date August 14, 1991

Subscribed and sworn to before me this 16th day of August 19 91

Notary Public Patricia S. Merz Date Commission Expires 2-14-93

PATRICIA S. MERZ  
NOTARY PUBLIC  
STATE OF KANSAS  
My Appt. Exp. 2-14-93

PI

SIDE TWO

Operator Name Mid Continent Resources Lease Name Cotton Well # 2C-85

Sec. 6 Twp. 32 Rge. 32  
 East  
 West

County Seward

RECOMPLETION FORMATION DESCRIPTION

Log  Sample

Name NO NEW DRILLING Top Bottom

NO NEW DRILLING

ADDITIONAL CEMENTING/SQUEEZE RECORD None

Purpose:	Depth		Type of Cement	# Sacks Used	Type and Percent Additives
	Top	Bottom			
<input type="checkbox"/> Perforate					
<input type="checkbox"/> Protect Casing					
<input type="checkbox"/> Plug Back TD					
<input type="checkbox"/> Plug Off Zone					

Shots Per Foot	PERFORATION RECORD		Acid, Fracture, Shot, Cement Squeeze Record (Amount and Kind of Material Used)
	Specify Footage of Each Interval Perforated		
	No new perforations		No new acid treatment

PBTD 5650 Plug Type CIBP

TUBING RECORD

Size 2 3/8 Set At 4782' Packer At 4782' Was Liner Run Y X N

Date of Resumed Production, Disposal or Injection New injection well-no injection pending

Estimated Production Per 24 Hours Oil ---- KCC approval Bbls. Water ---- Bbls. Gas-Oil-Ratio  
 Gas ---- Mcf

Disposition of Gas: NA

Vented  Sold  Used on Lease (If vented, submit ACO-18.)