

SIDE ONE

STATE CORPORATION COMMISSION OF KANSAS
OIL & GAS CONSERVATION DIVISION
WELL COMPLETION FORM
ACO-1 WELL HISTORY
DESCRIPTION OF WELL AND LEASE


Operator: License # 5003
Name: McCoy Petroleum Corporation
Address 110 S. Main, Suite 500
city/State/zip Wichita, Kansas 67202
Purchaser: _____
Operator Contact Person: Roger McCoy
Phone (316) 265-9697
Contractor: Name: Sweetman Drilling, Inc.
License: 5658
Wellsite Geologist: John Hastings

Designate Type of Completion
 New Well Re-Entry Workover
 Oil SWD Temp. Abd.
 Gas Inj Delayed Comp.
 Dry Other (Core, Water Supply, etc.)

If OWMO: old well info as follows:
Operator: _____
Well Name: _____
Comp. Date _____ Old Total Depth _____

Drilling Method:
 Mud Rotary Air Rotary Cable
11-26-89 12-09-89 12-09-89
Spud Date Date Reached TD Completion Date

API NO. 15- 189-21,397-00-00
County Stevens
C NW NW Sec. 5 Twp. 33S Rge. 37 East West
4620' Ft. North from Southeast Corner of Section
4620' Ft. West from Southeast Corner of Section
(NOTE: Locate well in section plat below.)
Lease Name Schmidt "A" Well # 1-5
Field Name Gentzler Area
Producing Formation _____
Elevation: Ground 3143' KB 3153'
Total Depth 6640' PBTD _____

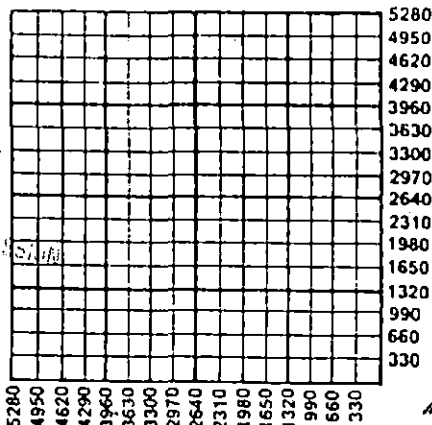

Amount of Surface Pipe Set and Cemented at 1763 Feet
Multiple Stage Cementing Collar Used? Yes No
If yes, show depth set _____ Feet
If Alternate II completion, cement circulated from _____
feet depth to _____ w/ _____ sx cnt.

RECEIVED
12-12-89
12 1989
STATE CORPORATION COMMISSION
WICHITA, KANSAS


AITI OYA

INSTRUCTIONS: This form shall be completed in triplicate and filed with the Kansas Corporation Commission, 200 Colorado Derby Building, Wichita, Kansas 67202, within 120 days of the spud date of any well. Rule 82-3-130, 82-3-107 and 82-3-106 apply. Information on side two of this form will be held confidential for a period of 12 months if requested in writing and submitted with the form. See rule 82-3-107 for confidentiality in excess of 12 months. One copy of all wireline logs and drillers time log shall be attached with this form. ALL CEMENTING TICKETS MUST BE ATTACHED. Submit CP-4 form with all plugged wells. Submit CP-111 form with all temporarily abandoned wells. Any recompletion, workover or conversion of a well requires filing of ACO-2 within 120 days from commencement date of such work.

All requirements of the statutes, rules and regulations promulgated to regulate the oil and gas industry have been fully complied with and the statements herein are complete and correct to the best of my knowledge.

Signature [Signature]
Title President Date _____
Subscribed and sworn to before me this 11 day of December, 19 89.
Notary Public Deborah Ann Paulus
Date Commission Expires 1-8-92

K.C.C. OFFICE USE ONLY
 Letter of Confidentiality Attached
 Wireline Log Received
 Drillers Timelog Received
Distribution
 KCC SWD/Rep NGPA
 KGS Plug Other
(Specify)

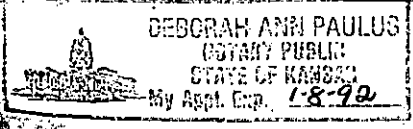

4 p1