

This form shall be filed in triplicate with the Kansas Corporation Commission, 200 Colorado Trust Building, Wichita, Kansas 67202, within ten days after the completion of the well, regardless of how the well was completed. Circle one: Oil, gas, dry, SWD, SWD, injection. Type and complete ALL sections. Applications must be filed for dual completion, commingling, salt water disposal and injection. Attach wireline logs (i.e. electrical log, sonic log, gamma ray neutron log, etc.) KCC#-(316)263-3238.

OPERATOR TXO Production Corp.

API NO. 15-007-21,185-00-00

ADDRESS 200 W. Douglas, Suite 300  
Wichita, Kansas 67202

COUNTY Barber

FIELD Aetna

CONTACT PERSON Harold R. Trapp

PROD. FORMATION N/A

PHONE 265-9441

LEASE Z-Bar Cattle Co.

PURCHASER N/A

WELL NO. Z-Bar Cattle Co. #5

ADDRESS N/A

WELL LOCATION

DRILLING FWA, Rig #31

660 Ft. from North Line and


CONTRACTOR 251 N. Water

1320 Ft. from East Line of

ADDRESS Wichita, KS 67202

the 24 SEC. 34S TWP. 15W RGE.

PLUGGING Same

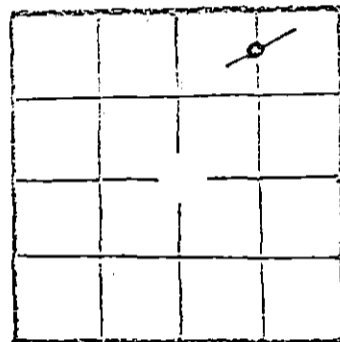

WELL PLAT

CONTRACTOR ADDRESS

KCC   
KGS   
MISC   
(Office Use)

TOTAL DEPTH 4897 PBD 4885

Drop till P&A,

SPUD DATE 8-8-81 DATE COMPLETED 10-12-81

ELEV: GR 1673 DF N/A KB 1684

DRILLED WITH ~~(CASE)~~ (ROTARY) ~~(CASE)~~ TOOLS (New) / ~~(CASE)~~ casing.

CASING RECORD

Report of all strings set — surface, intermediate, production, etc.

Purpose of string	Size hole drilled	Size casing set (in O.D.)	Weight lbs/ft.	Setting depth	Type cement	Socks	Type and percent additives
Surface	11"	8-5/8"	24#	958'		200 lite + 100 sxs common	
Production		4-1/2"	10.5#	4896'		175 sxs	

LINER RECORD

PERFORATION RECORD

Top, ft.	Bottom, ft.	Socks cement	Shots per ft.	Size & type	Depth interval
N/A	N/A	N/A	4 JSPF (12 h.)		4856-59'
TUBING RECORD			2 JSPF (22 h.)		4848-53' & 4830-35'
Size	Setting depth	Packer set at	Shots per ft.	Size & type	Depth interval
2-3/8"	4824.71'	4802.01'	2 JSPF (11 h.)	Miss.	4830-35'

ACID, FRACTURE, SHOT, CEMENT SQUEEZE RECORD

Amount and kind of material used	Depth interval treated
Squeezed w/150 sxs Class "A" w.75% D-65	4848-53' & 4830-35'
Acidized w/500 gal 15% HCl w/cia-Sta & surfactant	4830-35'
Acidized w/1500 gals 15% HCl w/cia-sta & 30 ball sealers	"
Fraced in complex gel w/25,000# of 20-40 sand & 17,500# 10-20 sand	4830-35'

Date of first production Drop till P & A, 10-12-81 Producing method (flowing, pumping, gas lift, etc.) dry Gravity N/A

Oil 1.67 BO Gas 38 MCFD Water N/A % GOR on 10/11 12.5

DATE OF PRODUCTION 10-12-81 WELL NO. 15-007-21,185-00-00 FIELD Aetna COUNTY Barber STATE KANSAS

Conservation Division  
Wichita, Kansas  
FEB 10 1982  
2-10-82

Estimated height of cement behind Surface Pipe Unknown Depth W/A

Estimated height of cement behind Surface Pipe 4/4

IN CORRECT

WELL LOG

Formation Description, Contents, etc.	Top	Bottom	Name	Depth
<u>LOG TOPS</u>				
Herington	2156	-472		
Towanda	2294	-610		
Cottonwood	2722	-1038		
Onaga	3034	-1350		
Indian Cave	3048	-1364		
Wabaunsee	3098	-1414		
Topeka	3530	-1846		
Heebner	4004	-2320		
Douglas	4040	-2356		
Lansing	4233	-2549		
Swope	4613	-2929		
5/Kansas City	4714	-3090		
Pawnee	4761	-3077		
Cherokee	4812	-3118		
Miss.	4831	-3147		
RTD	4870			
LTD	4891			
PSC	4885			
Run C.H. Logs				
No DSTs.				

A F F I D A V I T

STATE OF KANSAS, COUNTY OF SEDGWICK SS, Mr.

Harold A. Brown OF LAWFUL AGE, BEING FIRST DULY SWORN UPON HIS OATH,

DEPOSES THAT HE IS District Exploration Mgr. (FOR) ~~XXX~~ TXO Production Corp.

OPERATOR OF THE Z-Bar Cattle Co. LEASE, AND IS DULY AUTHORIZED TO MAKE

THIS AFFIDAVIT FOR AND ON THE BEHALF OF SAID OPERATOR, THAT WELL NO. 5 ON

SAID LEASE HAS BEEN COMPLETED AS OF THE 12th DAY OF October, 1921, AND THAT

ALL INFORMATION ENTERED HEREIN WITH RESPECT TO SAID WELL IS TRUE AND CORRECT.

FURTHER AFFIANT SAITH NOT.

(S) Harold A. Brown

WIT FOR ME THIS 3rd DAY OF December 1921

GAYLE E. Mc...  
Sedgwick County, KS  
Notary Public

[Signature]