

SIDE ONE

STATE CORPORATION COMMISSION OF KANSAS
OIL & GAS CONSERVATION DIVISION
RECOMPLETION FORM
ACO-2 AMENDMENT TO WELL HISTORY

API NO. 15- 15-129-19001-00-02

County Morton East
SE SE NW Sec 10 Twp 33S Rge 42 West

Operator: License # 7117
Name Colorado Interstate Gas Company
Address P. O. Box 1087
Colorado Springs, CO
City/State/Zip 80944

2970 Ft North from Southeast Corner of Section
2970 Ft West from Southeast Corner of Section
(Note: Locate well in section plat below)

Lease Name Boehm Well # 6

Purchaser N/A

Field Name Boehm Storage Field

Operator Contact Person D. I. Veatch
Phone (316) 592-2751

Name of New Formation Keyes Sand

Elevation: Ground 3477' KB 3487'
Section Plat

Designate Type of Original Completion
 New Well Re-Entry Workover

Oil SWD Temp Abd
 Gas Inj Delayed Comp.
 Dry Other (Core, Water Supply etc)


Date of Original Completion: 3-19-57

DATE OF RECOMPLETION:
2-20-85 4-29-85
Commenced Completed

Designate Type of Recompletion/Workover:
 Deepening Delayed Completion

Plug Back Re-perforation plus run
& cement 3 1/2" tubing string
 Conversion to Injection/Disposal

Is recompleted production:
 Commingled; Docket No. _____
 Dual Completion; Docket No. _____
 Other (Disposal or Injection)?
(Gas Storage Well)

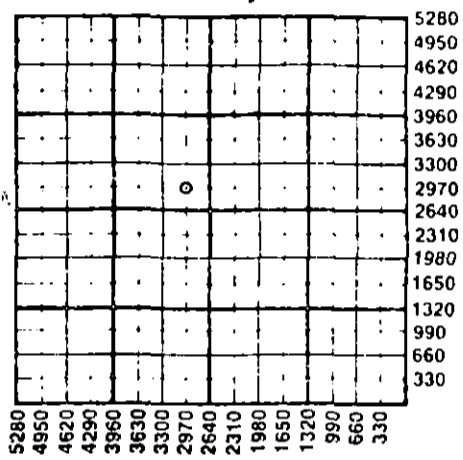

K.C.C. OFFICE USE ONLY
F Letter of Confidentiality Attached
C Wireline Log Received
C Drillers Timelog Received
Distribution
 KCC SWD/Rep NGPA
 KGS Plug Other
(Specify)

(original & two copies)

INSTRUCTIONS: This form shall be completed in triplicate and filed with the Kansas Corporation Commission, 200 Colorado Derby Building, Wichita, Kansas 67202, within 120 days of the recompletion of any well. Rules 82-3-107 and 82-3-141 apply. Information on side two of this form will be held confidential for a period of 12 months if requested in writing and submitted with the form. See rule 82-3-107 for confidentiality in excess of 12 months. One copy of any additional wireline logs and driller's time logs (not previously submitted) shall be attached with this form. Submit ACO-4 prior to or with this form for approval of commingling or dual completions. Submit CP-4 with all plugged wells. Submit CP-111 with all temporarily abandoned wells. NOTE: Conversion of wells to either disposal or injection must receive approval before use; submit form U-1.

All requirements of the statutes, rules and regulations promulgated to regulate the oil and gas industry have been fully complied with and the statements herein are complete and correct to the best of my knowledge.

Signature Anthony P. [Signature] Title Geologist Date 3-28-90
Subscribed and sworn to before me this 28th day of March 19 90
Notary Public Adna P. [Signature] Date Commission Expires 2-5-94

X P1

ORIGINAL

SIDE TWO

Operator Name Colorado Interstate Gas Company Lease Name Boehm Well # 6

Sec 10 Twp 33S Rge 42 East West County Morton

RECOMPLETED FORMATION DESCRIPTION:

Log Sample

Name	Top	Bottom
Keyes Sand	4850GL	4926GL

ADDITIONAL CEMENTING/SQUEEZE RECORD

Purpose:	Depth		Type of Cement	# Sacks Used	Type & Percent Additives
	Top	Bottom			
<input type="checkbox"/> Perforate	Surf	5037'	Howco Lite	600sx	3/4% CFR-2
<input checked="" type="checkbox"/> Protect Casing (1)			50-50 POZ	25sx	2% GEL; 3/4% GFR-2
<input type="checkbox"/> Plug Back TD					
<input type="checkbox"/> Plug Off Zone					

Shots Per Foot	PERFORATION RECORD	Acid, Fracture, Shot, Cement Squeeze Record
	Specify Footage of Each Interval Perforated	(Amount and Kind of Material Used)
4	4852'-4862'GL	5000 GAL 15% MSr-150 ACID

PBTD 5007' Plug Type Cement/Casing Shoe

TUBING RECORD:

Size -- Set At -- Packer At -- Was Liner Run? Y N

Date of Resumed Production, Disposal or Injection 4-29-85

Estimated Production Per 24 Hours -- bbl/oil -- bbl/water

N/A MCF gas -- gas-oil ratio
(Gas Storage Well)

(1) Cemented 5040.13' of 3-1/2" 9.3# K-55 8R EUE "Casing" at 5037'.