

STATE CORPORATION COMMISSION OF KANSAS  
OIL & GAS CONSERVATION DIVISION  
WELL COMPLETION OR RECOMPLETION FORM  
ACO-1 WELL HISTORY  
DESCRIPTION OF WELL AND LEASE

Operator: License # 5598  
Name APX Corporation  
Address P. O. Box 351  
City/State/Zip Liberal, Kansas 67905-0351

Purchaser Panhandle Eastern Pipe Line Co.  
(Transporter)

Operator Contact Person M. L. Pease  
Phone (316) 624-6253

Contractor: License # 5842  
Name Gabbert-Jones, Inc.

Wellsite Geologist NA  
Phone

Designate Type of Completion  
 New Well  Re-Entry

Oil  SWD  
 Gas  Inj  
 Dry  Other (Core, Water Supply, etc.)

If OWO: old well info as follows:  
Operator  
Well Name  
Comp. Date  
Old Total Depth

WELL HISTORY

Drilling Method:  
 Mud Rotary  Air Rotary  Cable  
7/16/88 7/20/88  
Spud Date Date Reached TD Completion Date  
2865 2852  
Total Depth PBTD

Amount of Surface Pipe Set and Cemented at 567 feet  
Multiple Stage Cementing Collar Used?  Yes  No  
If yes, show depth set feet  
If alternate 2 completion, cement circulated from feet depth to w/.....SX cmt  
Cement Company Name Halliburton Services  
Invoice # 769399

API No. 15-129-20,925-00-00  
County Morton

NW SE SE Sec. 30 Twp. 33S Rge. 39 East  
..... X West

1250 Ft North from Southeast Corner of Section  
1250 Ft West from Southeast Corner of Section  
(Note: Locate well in section plat below)


Lease Name Slemp "A" Well # 1H

Field Name Hugoton

Producing Formation Chase

Elevation: Ground 3267.0 KB

Section Plat

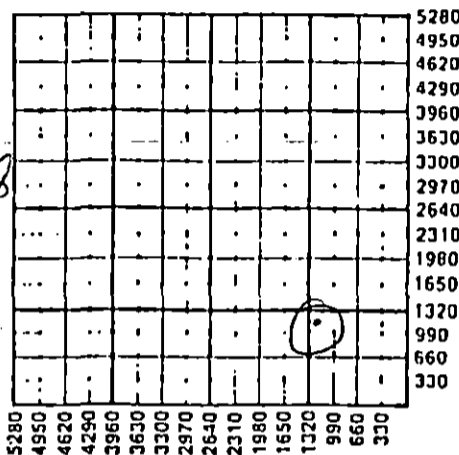

WATER SUPPLY INFORMATION

Disposition of Produced Water:  Disposal  
Docket #  Repressuring

Questions on this portion of the ACO-1 call:

Water Resources Board (913) 296-3717

Source of Water:  
Division of Water Resources Permit #

Groundwater.....Ft North from Southeast Corner  
(Well) .....Ft West from Southeast Corner of  
Sec Twp Rge East West

Surface Water.....Ft North from Southeast Corner  
(Stream, pond etc).....Ft West from Southeast Corner  
Sec Twp Rge East West

Other (explain) Contractor provided water  
(purchased from city, R.W.D. #)

INSTRUCTIONS: This form shall be completed in triplicate and filed with the Kansas Corporation Commission, 200 Colorado Derby Building, Wichita, Kansas 67202, within 120 days of the spud date of any well. Rule 82-3-130, 82-3-107 and 82-3-106 apply.

Information on side two of this form will be held confidential for a period of 12 months if requested in writing and submitted with the form. See rule 82-3-107 for confidentiality in excess of 12 months. One copy of all wireline logs and drillers time log shall be attached with this form. Submit CP-4 form with all plugged wells. Submit CP-111 form with all temporarily abandoned wells.

All requirements of the statutes, rules and regulations promulgated to regulate the oil and gas industry have been fully complied with and the statements herein are complete and correct to the best of my knowledge.

Signature D. W. Kapple  
Title Division Production Engineer Date 11/14/88

Subscribed and sworn to before me this 14th day of Nov. 1988  
Notary Public  
Date Commission Expires

NOTARY PUBLIC  
STATE OF KANSAS  
MY APPL. EXPIRES 1-0-91

K.C.C. OFFICE USE ONLY  
 Letter of Confidentiality Attached  
 Wireline Log Received  
 Drillers Timelog Received  
Distribution  
 KCC  SWD/Rap  NGPA  
 KGS  Plug  Other  
(Specify)  
11-15-88

Sec. 20 Twp. 33S Rge. 39E