

STATE CORPORATION COMMISSION OF KANSAS  
OIL & GAS CONSERVATION DIVISION  
RECOMPLETION FORM  
ACC-2 AMENDMENT TO WELL HISTORY

API NO. 15- 129-20,925 -00-01

County Morton

NW SE SE Sec 30 Twp 33S Rge 39 X East West

Operator: License # 5598  
Name APX Corporation  
Address P. O. Box 351

1250 Ft North from Southeast Corner of Section  
1250 Ft West from Southeast Corner of Section  
(Note: Locate well in section plat below)

City/State/Zip Liberal, Kansas 67905-0351

Lease Name Slemp "A" Well # 1H

Purchaser Panhandle Eastern Pipe Line Co.  
(Transporter)

Field Name Hugoton

Operator Contact Person M. L. Pease  
Phone (316) 624-6253

Name of New Formation Chase

Elevation: Ground 3267.0 KB NA

Section Plat

Designate Type of Original Completion  
 New Well  Re-Entry  Workover  
  
 Oil  SWD  Temp Abd  
 Gas  Inj  Delayed Comp.  
 Dry  Other (Core, Water Supply etc.)

Date of Original Completion: 11-21-88

DATE OF RECOMPLETION:

Commenced \_\_\_\_\_ Completed \_\_\_\_\_

Designate Type of Recompletion/Workover:

Deepening  Delayed Completion

Plug Back  Re-perforation

Conversion to Injection/Disposal


Is recompleted production:

Commingled; Docket No. \_\_\_\_\_

Dual Completion; Docket No. \_\_\_\_\_

Other (Disposal or Injection)?

1-25-88  
RECEIVED  
STATE CORPORATION COMMISSION  
JAN 25 1989  
CONSERVATION DIVISION  
Wichita, Kansas

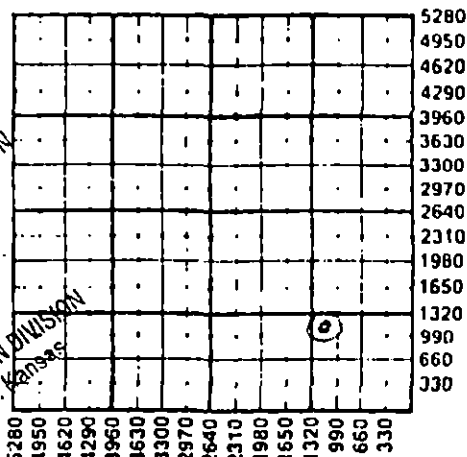

K. C. C. OFFICE USE ONLY  
 Letter of Confidentiality Attached  
 Wireline Log Received  
 Drillers Timelog Received  
Distribution  
 KCC  SWD/Rep  NGPA  
 KGS  Plug  Other  
(Specify)  
.....  
.....  
1-25-89

INSTRUCTIONS: This form shall be completed in triplicate and filed with the Kansas Corporation Commission, 200 Colorado Derby Building, Wichita, Kansas 67202, within 120 days of the recompletion of any well. Rules 82-3-107 and 82-3-141 apply. Information on side two of this form will be held confidential for a period of 12 months if requested in writing and submitted with the form. See rule 82-3-107 for confidentiality in excess of 12 months. One copy of any additional wireline logs and driller's time logs (not previously submitted) shall be attached with this form. Submit ACC-4 prior to or with this form for approval of commingling or dual completions. Submit OP-4 with all plugged wells. Submit OP-111 with all temporarily abandoned wells. NOTE: Conversion of wells to either disposal or injection must receive approval before use; submit form U-1.

All requirements of the statutes, rules and regulations promulgated to regulate the oil and gas industry have been fully complied with and the statements herein are complete and correct to the best of my knowledge.

Signature M. L. Pease Title Division Production Mgr. Date 1/23/89  
M. L. Pease

Subscribed and sworn to before me this 24th day of January 19 89

Notary Public Glenn S. Bailey Date Commission Expires \_\_\_\_\_

GLENN S. BAILEY  
NOTARY PUBLIC  
1-6-91