

STATE CORPORATION COMMISSION OF KANSAS
OIL & GAS CONSERVATION DIVISION

WELL COMPLETION OR RECOMPLETION FORM
ACO-1 WELL HISTORY

DESCRIPTION OF WELL AND LEASE

Operator: License # 5263
Name Midwestern Exploration Co.
Address P.O. Box 1884
City/State/Zip Liberal, Kansas 67905

* Purchaser Enron Gas Supply Co.
Tulsa, Oklahoma

Operator Contact Person Harold K. Frauli
Phone (316) 624-3534

Contractor: License # 5421
Name Sage Drilling Co.

Wellsite Geologist Joe Blair
Phone (405) 366-7558

Designate Type of Completion
 New Well Re-Entry Workover

Oil SWD Temp Abd
 Gas Inj Delayed Comp.
 Dry Other (Core, Water Supply etc.)

If OWWO: old well info as follows:
Operator
Well Name
Comp. Date Old Total Depth.....

WELL HISTORY

Drilling Method:
 Mud Rotary Air Rotary Cable
9-9-88 9-18-88 10-16-88
Spud Date Date Reached TD Completion Date
6042' 2816'
Total Depth PBDT

Amount of Surface Pipe Set and Cemented at 1605 feet
Multiple Stage Cementing Collar Used? Yes No
If yes, show depth set.....feet
If alternate 2 completion, cement circulated
from.....feet depth to.....w/.....SX cmt

API NO. 15-175-21-041-00-00

County..... Seward
250' West
NW/4 NW/4 Sec. 7 Twp. 32S Rge. 32 East West


4620 Ft North from Southeast Corner of Section
4870 Ft West from Southeast Corner of Section
(Note: Locate well in section plat below)

Lease Name..... Printz Well #..... 1-7

Field Name..... Hugoton

Producing Formation..... Hugoton Chase

Elevation: Ground..... 2844 KB..... 2854
Section Plat

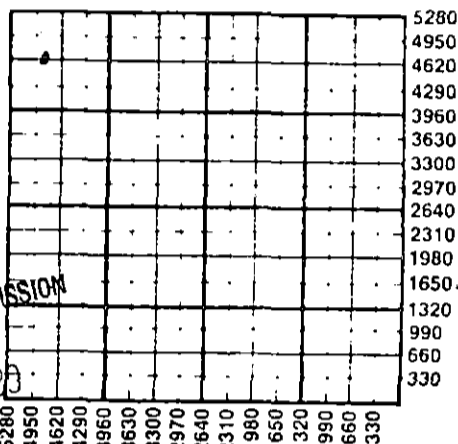

RECEIVED
STATE CORPORATION COMMISSION
NOV 1988
RECEIVED
STATE CORPORATION COMMISSION
1-25-89
JAN 25 1989
CONSERVATION DIVISION
Wichita, Kansas

WATER SUPPLY INFORMATION
Disposition of Produced Water: Disposal Repressuring
Docket #

Questions on this portion of the ACO-1 call:
Water Resources Board (913) 296-3717

Source of Water:
Division of Water Resources Permit #... T 88-452

Groundwater... 4745 Ft North from Southeast Corner
(Well) ... 4895 Ft West from Southeast Corner of
Sec 7 Twp 32S Rge 32 East West

Surface Water..... Ft North from Southeast Corner
(Stream, pond etc)..... Ft West from Southeast Corner
Sec Twp Rge East West


Other (explain).....
(purchased from city, R.W.D. #)

INSTRUCTIONS: This form shall be completed in duplicate and filed with the Kansas Corporation Commission, 200 Colorado Derby Building, Wichita, Kansas 67202, within 90 days after completion or recompletion of any well. Rule 82-3-130 and 82-3-107 apply.
Information on side two of this form will be held confidential for a period of 12 months if requested in writing and submitted with the form. See rule 82-3-107 for confidentiality in excess of 12 months.
One copy of all wireline logs and drillers time log shall be attached with this form. Submit CP-4 form with all plugged wells. Submit CP-111 form with all temporarily abandoned wells.

All requirements of the statutes, rules and regulations promulgated to regulate the oil and gas industry have been fully complied with and the statements herein are complete and correct to the best of my knowledge.

Signature
Title..... Agent Date 10-28-88

Subscribed and sworn to before me this 28th day of October
1988
Notary Public..... Mary Morgan
Date Commission Expires..... October 3, 1992

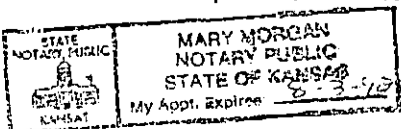

K.C.C. OFFICE USE ONLY
 Letter of Confidentiality Attached
 Wireline Log Received
 Drillers Timelog Received
Distribution
 KCC SWD/Rep NGPA
 KGS Plug Other
(Specify)
1-25-89
Form ACO-1 (7-84)

Sec. 7, Twp. 32S Rge. 32