

This form shall be filed in duplicate with the Kansas Corporation Commission, 200 Colorado Derby Building, Wichita, Kansas 67202, within ten days after the completion of the well, regardless of how the well was completed.

Attach separate letter of request if the information is to be held confidential. If confidential, only file one copy. Information on side one will be of public record and side two will then be held confidential.

Circle one: Oil, Gas, Dry, SWD, OWWO, Injection. Type and complete ALL sections. Gas Storage Applications must be filed for dual completion, commingling, SWD and injection.

Attach wireline logs (i.e. electrical log, sonic log, gamma ray neutron log, etc.). KCC # (316) 263-3238. (Rules 82-2-105 & 82-2-125)

OPERATOR Southwest Gas Storage Company

API NO. 15 119 20547-00-00

ADDRESS P. O. Box 1348

COUNTY Meade

Kansas City, Missouri 64141

FIELD Borchers North

**CONTACT PERSON Mr. D. R. Carlile

PROD. FORMATION Morrow

PHONE (316) 873-5469

LEASE Harris

PURCHASER Panhandle Eastern Pipe Line Company

WELL NO. 2-4

ADDRESS P. O. Box 1348

WELL LOCATION 395'S & 1267'E from

Kansas City, Missouri 64141

Ft. from _____ Line and

DRILLING Sage Drilling Company, Inc.

Ft. from _____ Line of


CONTRACTOR

ADDRESS 222 Sutton Place

the NW/4 SEC. 4 TWP. 33S RGE 28W

Kansas City, Missouri 67202

WELL PLAT

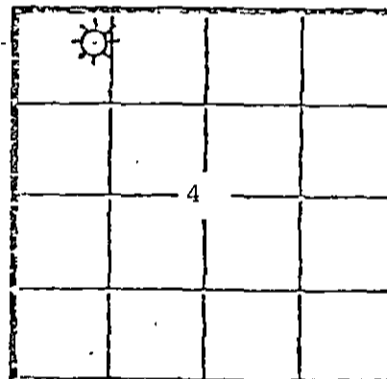

KCC
KGS
(Office Use)

6-9-82

PLUGGING _____

CONTRACTOR _____

ADDRESS _____

TOTAL DEPTH 5752' PBD 5725'

SPUD DATE 12-17-81 DATE COMPLETED 2-4-82

ELEV: GR 2424' DF _____ KB _____

DRILLED WITH (CABLE) (ROTARY) (AIR) TOOLS

Amount of surface pipe set and cemented 2485' DV Tool Used? RECEIVED

AFFIDAVIT

STATE OF KANSAS, COUNTY OF MEADE SS, I,

D. R. CARLILE OF LAWFUL AGE, BEING FIRST DULY SWORN UPON

DEPOSES THAT HE IS FIELD SUPERINTENDENT (FOR)(OF) SOUTHWEST GAS STORAGE COMPANY

OPERATOR OF THE BORCHERS NORTH GAS STG. FIELD LEASE, AND IS DULY AUTHORIZED TO MAKE

THIS AFFIDAVIT FOR AND ON THE BEHALF OF SAID OPERATOR, THAT WELL NO. 2-4 ON

SAID LEASE HAS BEEN COMPLETED AS OF THE 4th DAY OF FEBRUARY, 19 82, AND THAT

ALL INFORMATION ENTERED HEREIN WITH RESPECT TO SAID WELL IS TRUE AND CORRECT.

FURTHER AFFIANT SAITH NOT.

(S) [Signature]

SUBSCRIBED AND SWORN BEFORE ME THIS 7th DAY OF June, 19 82

appt,
MY COMMISSION EXPIRES: June 16, 1982

[Signature]
NOTARY PUBLIC Wilma Pennington

**The person who can be reached by phone regarding any questions concerning this information. Within 45 days of completion, a witnessed initial test by the Commission is required if the well produces more than 25 FOPD or is located in a Basic Order Pool.