

STATE CORPORATION COMMISSION OF KANSAS
OIL & GAS CONSERVATION DIVISION
WELL COMPLETION OR RECOMPLETION FORM
ACO-1 WELL HISTORY
DESCRIPTION OF WELL AND LEASE

API NO. 15-119-20-780-00-00

County Meade

NE/4 NE/4 Sec. 35 Twp. 34S Rge. 27 East
West

4620 Ft North from Southeast Corner of Section
660 Ft West from Southeast Corner of Section
(Note: Locate well in section plat below)


Lease Name Will Rodgers Well # 1-35

Field Name None

Producing Formation None

Elevation: Ground 2190 KB 2203

Section Plat

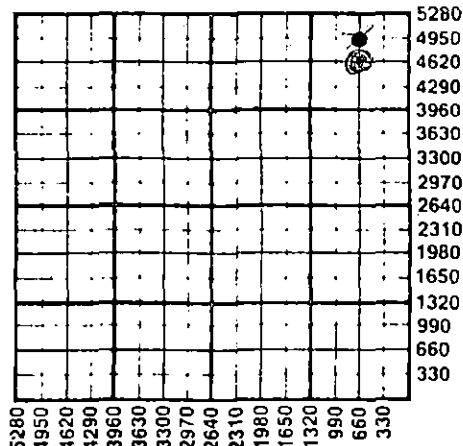

WATER SUPPLY INFORMATION

Disposition of Produced Water: Disposal
Docket # Repressuring

Questions on this portion of the ACO-1 call:

Water Resources Board (913) 296-3717

Source of Water:
Division of Water Resources Permit #

Groundwater Ft North from Southeast Corner
(Well) Ft West from Southeast Corner of
Sec Twp Rge East West

X Surface Water 3960 Ft North from Southeast Corner
(Stream, pond etc) 3300 Ft West from Southeast Corner
Sec 35 Twp 34S Rge 27 East X West

Other (explain)
(purchased from city, R.W.D. #)

Operator: License # 08060
Name Zinke & Trumba, Ltd.
Address 1202 E. 33rd St. Suite 100
Tulsa, OK 74103
City/State/Zip

Purchaser

Operator Contact Person Keith Hill
Phone (316) 524-0156

Contractor: License # 05380
Name Eagle Drilling, Inc.

Wellsite Geologist
Phone

Designate Type of Completion

X New Well Re-Entry Workover
Oil SWD Temp Abd
Gas Inj Delayed Comp.
Y Dry Other (Core, Water Supply etc.)

If ONNO: old well info as follows:

Operator
Well Name
Comp. Date Old Total Depth

WELL HISTORY

Drilling Method:

X Mud Rotary Air Rotary Cable

7-6-88 7-17-88 7-18-88
Spud Date Date Reached TD Completion Date

6500
Total Depth PBTD

Amount of Surface Pipe Set and Cemented at 560 feet
Multiple Stage Cementing Collar Used? Yes X No
If yes, show depth set feet
If alternate 2 completion, cement circulated
from feet depth to w/SX cmt
Cement Company Name BJ Titan
Invoice # Turnkey
A J D Inc

INSTRUCTIONS: This form shall be completed in triplicate and filed with the Kansas Corporation Commission, 200 Colorado Derby Building, Wichita, Kansas 67202, within 120 days of the spud date of any well. Rule 82-3-130, 82-3-107 and 82-3-106 apply. Information on side two of this form will be held confidential for a period of 12 months if requested in writing and submitted with the form. See rule 82-3-107 for confidentiality in excess of 12 months. One copy of all wireline logs and drillers time log shall be attached with this form. Submit CP-4 form with all plugged wells. Submit CP-111 form with all temporarily abandoned wells.

All requirements of the statutes, rules and regulations promulgated to regulate the oil and gas industry have been fully complied with and the statements herein are complete and correct to the best of my knowledge.

Signature Keith Hill

Title Agent Date 7-21-88

Subscribed and sworn to before me this 21st day of July 1988

Notary Public Charles A. Vecchiarelli

Date Commission Expires

CHARLES A. VECCHIARELLI
NOTARY PUBLIC
STATE OF KANSAS
MY APPT. EXPIRES 4-28-90

K.C.C. OFFICE USE ONLY
Letter of Confidentiality Attached
C 211 Form Received
C Drillers Time Log Received
Distribution
KCC JUL 21 1988 SWD/Rep NGPA
KGS Plug Other
CONSERVATION DIVISION (Specify)
Wichita, Kansas
7-27-88
Form ACO-1 (5-86)

7-27-88

Sec. 35 Twp. 34 Rge. 27