

SIDE ONE

STATE CORPORATION COMMISSION OF KANSAS
OIL & GAS CONSERVATION DIVISION
WELL COMPLETION OR RECOMPLETION FORM
ACO-1 WELL HISTORY

S

API NO. 15-189-21,025-00-00
County Stevens
C SW Sec. 22 Twp. 33S Rge. 39 East West

DESCRIPTION OF WELL AND LEASE

1320 Ft North from Southeast Corner of Section
3960 Ft West from Southeast Corner of Section
(Note: Locate well in section plat below)

Operator: License # 4549
Name Anadarko Petroleum Corporation
Address P.O. Box 351
City/State/Zip Liberal, Kansas 67901

Lease Name DEMUTH "B" Well # 2

Field Name Wildcat Demuth Disc

Purchaser NONE


Producing Formation Lower Morrow

Elevation: Ground 3226.9 KB 3239

Operator Contact Person Jim Barlow
Phone 316-624-6252

Section Plat

Contractor: License # 5842
Name Gabbert-Jones, Inc.

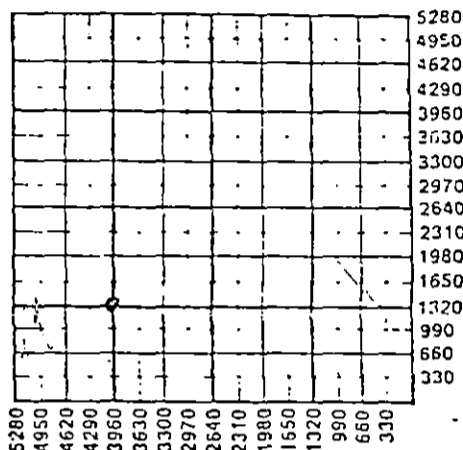

Wellsite Geologist Eric Drummond
Phone 303-595-3326

WATER SUPPLY INFORMATION

Disposition of Produced Water: Disposal Repressuring
Docket #

Questions on this portion of the ACO-1 call:

Water Resources Board (913) 296-3717
Source of Water:
Division of Water Resources Permit #

Groundwater.....Ft North from Southeast Corner (Well)Ft West from Southeast Corner of Sec Twp Rge East West

Surface Water.....Ft North from Southeast Corner (Stream, pond etc).....Ft West from Southeast Corner Sec Twp Rge East West

Other (explain) Drilling Contractor furnished water (purchased from city, R.W.D. #)

WELL HISTORY

Drilling Method:
 Mud Rotary Air Rotary Cable
3/21/87 4/4/87 5/7/87
Spud Date Date Reached TD Completion Date
6500 6425
Total Depth PSTD

Amount of Surface Pipe Set and Cemented at 1690 feet
Multiple Stage Cementing Collar Used? Yes No
If yes, show depth set.....3022.....feet
If alternate 2 completion, cement circulated from.....feet depth to.....w/.....SX cmt

INSTRUCTIONS: This form shall be completed in duplicate and filed with the Kansas Corporation Commission, 200 Colorado Derby Building, Wichita, Kansas 67202, within 90 days after completion or recompletion of any well. Rule 82-3-130 and 82-3-107 apply. Information on side two of this form will be held confidential for a period of 12 months if requested in writing and submitted with the form. See rule 82-3-107 for confidentiality in excess of 12 months. One copy of all wireline logs and drillers time log shall be attached with this form. Submit CP-4 form with all plugged wells. Submit CP-111 form with all temporarily abandoned wells.

All requirements of the statutes, rules and regulations promulgated to regulate the oil and gas industry have been fully complied with and the statements herein are complete and correct to the best of my knowledge.

Signature David W. Kapple
David W. Kapple
Title.....Division Production Engineer Date 5/20/87

Subscribed and sworn to before me this 26th day of May 1987
Notary Public
Date Commission Expires

K.C.C. OFFICE USE ONLY

Letter of Confidentiality Attached
 Wireline Log Received
 Drillers Timelog Received

Distribution
 KCC SWD/Rep NGPA
 KGS Plug Other (Specify)

STATE CORPORATION COMMISSION

Sec 32, Twp. 33, Rge 29