

COPY

CONFIDENTIAL  
CONFIDENTIAL

SIDE ONE

STATE CORPORATION COMMISSION OF KANSAS  
OIL & GAS CONSERVATION DIVISION  
WELL COMPLETION FORM  
ACO-1 WELL HISTORY  
DESCRIPTION OF WELL AND LEASE

API NO. 15- 025-21,053-40-00

County Clark

NE SW SW Sec. 3 Twp. 34S Rge. 25  East West

990 Ft. North from Southeast Corner of Section

4290 Ft. West from Southeast Corner of Section  
(NOTE: Locate well in section plat below.)


Lease Name Harden Farms Well # 1-3

Field Name McKinney

Producing Formation Morrow

Elevation: Ground 2057 KB 2070

Total Depth 5890 PBTD 5600

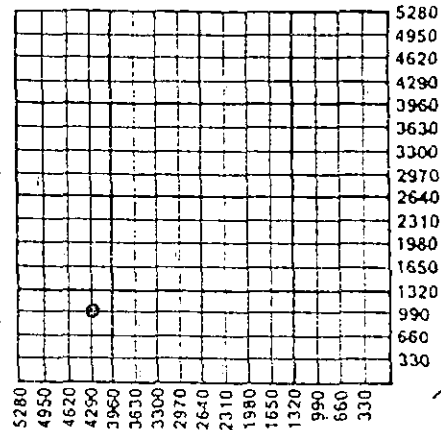

Amount of Surface Pipe Set and Cemented at 669 Feet

Multiple Stage Cementing Collar Used?  Yes  No

If yes, show depth set \_\_\_\_\_ Feet

If Alternate II completion, cement circulated from \_\_\_\_\_

feet depth to \_\_\_\_\_ w/ \_\_\_\_\_ sx cmt.

Operator: License # 30444

Name: Charter Production Company

Address 224 E. Douglas - Suite 400

City/State/Zip Wichita KS 67202

Purchaser: unknown

Operator Contact Person: Robert C. Spurlock

Phone (316)264-2808

Contractor: Name: Eagle Drilling

License: 5380

Wellsite Geologist: Robert Smith

Designate Type of Completion

New Well  Re-Entry  Workover

Oil  SWD  Temp. Abd.

Gas SI  Inj  Delayed Comp.

Dry  Other (Core, Water Supply, etc.)

If OAWO: old well info as follows:

Operator: \_\_\_\_\_

Well Name: \_\_\_\_\_

Comp. Date \_\_\_\_\_ Old Total Depth \_\_\_\_\_

Drilling Method:

Mud Rotary  Air Rotary  Cable

10/25/90 11/05/90 11/18/90

Spud Date Date Reached TD Completion Date

INSTRUCTIONS: This form shall be completed in triplicate and filed with the Kansas Corporation Commission, 200 Colorado Derby Building, Wichita, Kansas 67202, within 120 days of the spud date of any well. Rule 82-3-130, 82-3-107 and 82-3-106 apply. Information on side two of this form will be held confidential for a period of 12 months if requested in writing and submitted with the form. See rule 82-3-107 for confidentiality in excess of 12 months. One copy of all wireline logs and drillers time log shall be attached with this form. ALL CEMENTING TICKETS MUST BE ATTACHED. Submit CP-4 form with all plugged wells. Submit CP-111 form with all temporarily abandoned wells. Any recompletion, workover or conversion of a well requires filing of ACO-2 within 120 days from commencement date of such work.

All requirements of the statutes, rules and regulations promulgated to regulate the oil and gas industry have been fully complied with and the statements herein are complete and correct to the best of my knowledge.

Signature Robert C. Spurlock

Robert C. Spurlock

Title President Date 01/15/91

Subscribed and sworn to before me this 15th day of January

19 91.

Notary Public Betty B. Herring

Betty B. Herring

Date Commission Expires 10/07/93

BETTY B. HERRING  
NOTARY PUBLIC  
STATE OF KANSAS  
My Appt. Exp. 10-07-93

K.C.C. OFFICE USE ONLY

F  Letter of Confidentiality Attached

C  Wireline Log Received

C  Drillers Timelog Received

Distribution

KCC  SWD/Rep  NGPA

KGS  Plug  Other (Specify)