

STATE CORPORATION COMMISSION OF KANSAS  
OIL & GAS CONSERVATION DIVISION  
WELL COMPLETION OR RECOMPLETION FORM  
ACO-1 WELL HISTORY  
DESCRIPTION OF WELL AND LEASE

Operator: License # 4549  
Name Anadarko Petroleum Corporation  
Address P.O. Box 351  
City/State/Zip Liberal, KS 67905-0351

Purchaser NA

Operator Contact Person M. L. Pease  
Phone (316) 624-6253

Contractor: License # 5842  
Name Gabbert-Jones, Inc.

Wellsite Geologist Mike Dodds  
Phone NA

Designate Type of Completion  
 New Well  Re-Entry  Workover  
 Oil  SWD  Temp Abd  
 Gas  Inj  Delayed Comp.  
 Dry  Other (Core, Water Supply etc.)

If ONWG: old well info as follows:  
Operator  
Well Name  
Comp. Date  
Old Total Depth

WELL HISTORY

Drilling Method:  
 Mud Rotary  Air Rotary  Cable  
7/20/89 7/30/89 Delayed  
Spud Date Date Reached TD Completion Date  
6625' 2889'  
Total Depth PBTD

Amount of Surface Pipe Set and Cemented at 1705 feet  
Multiple Stage Cementing Collar Used?  Yes  No  
If yes, show depth set...feet  
If alternate 2 completion, cement circulated from...feet depth to...w/...SX cmt  
Cement Company Name Halliburton Services  
Invoice # 823404

API NO. 15-189-21,359-00-00  
County Stevens  
NE SW SW Sec 20 Twp 33S Rge 38 East  
990 Ft North from Southeast Corner of Section  
4290 Ft West from Southeast Corner of Section  
(Note: Locate well in section plat below)


Lease Name GILBERT "A" Well # 1

Field Name Gentzler SW

Producing Formation NA

Elevation: Ground 3188.5 KB 3200.5

Section Plat

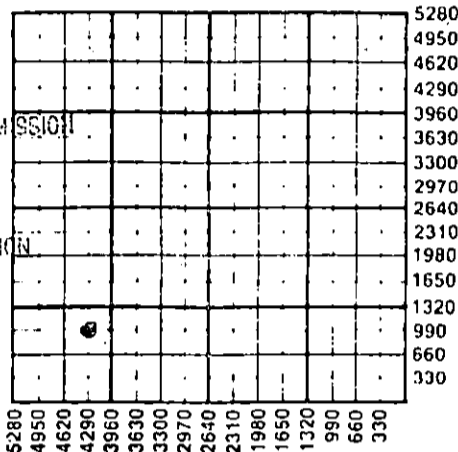

RECEIVED  
STATE CORPORATION COMMISSION  
Wichita, Kansas

WATER SUPPLY INFORMATION

Disposition of Produced Water:  Disposal  
Docket #  Repressuring

Questions on this portion of the ACO-1 call:  
Water Resources Board (913) 296-3717

Source of Water:  
Division of Water Resources Permit #

Groundwater...Ft North from Southeast Corner (Well) ...Ft West from Southeast Corner of Sec Twp Rge East West

Surface Water...Ft North from Southeast Corner (Stream, pond etc)...Ft West from Southeast Corner Sec Twp Rge East West

Other (explain) Contractor furnished water (purchased from city, R.W.D. #)

INSTRUCTIONS: This form shall be completed in triplicate and filed with the Kansas Corporation Commission, 200 Colorado Derby Building, Wichita, Kansas 67202, within 120 days of the spud date of any well. Rule 82-3-130, 82-3-107 and 82-3-106 apply. Information on side two of this form will be held confidential for a period of 12 months if requested in writing and submitted with the form. See rule 82-3-107 for confidentiality in excess of 12 months. One copy of all wireline logs and drillers time log shall be attached with this form. Submit CP-4 form with all plugged wells. Submit CP-111 form with all temporarily abandoned wells.

All requirements of the statutes, rules and regulations promulgated to regulate the oil and gas industry have been fully complied with and the statements herein are complete and correct to the best of my knowledge.

Signature M. L. Pease  
Title Division Production Manager Date 8/20/89

Subscribed and sworn to before me this 30th day of August 1989  
Notary Public Cheryl Steers

Date Commission Expires  
CHERYL STEERS  
Notary Public - State of Kansas  
My Appt. Expires 6-1-93

K.C.C. OFFICE USE ONLY  
 Letter of Confidentiality Attached  
 Wireline Log Received  
 Drillers Timelog Received  
Distribution  
 KCC  SWD/Rep  NGPA  
 KGS  Plug  Other  
(Specify)