

WELL PLUGGING RECORD

Give All Information Completely
 Make Required Affidavit

COUNTY Kingman SEC. 12 TWP. 30 RGE. 7 E/W
 Location as in quarters or footage from lines:
C/NE/NE

			●

Lease Owner Petroleum, Inc.
 Lease Name Messenger "Q" Well No. #3
 Office Address Box 1447 - Great Bend, Ks. 67530
 Character of Well (Completed as Oil, Gas or Dry Hole): Oil
 Date Well Completed March, 1969
 Application for plugging filed 1-19-83
 Plugging commenced March 3, 1983
 Plugging completed March 10, 1983
 Reason for abandonment of well or producing formation
Depleted

Locate Well
 correctly on above
 Section Platt.

Was permission obtained from the Conservation Division or it's
 Agent's before plugging was commenced? Yes

Name of Conservation Agent who supervised plugging of this well Maurice Leslie
 Producing formation Miss. Depth to top 4095' bottom 4111' T.D. 4111'
 Show depth and thickness of all water, oil and gas formations.

OIL, GAS OR WATER RECORDS

Casing Record

Formation	Content	From	To	Size	Put in	Pulled Out
				8 5/8"	250'	NONE
				5 1/2"	4097'	3273.97'

Describe in detail the manner in which the well was plugged, indicating where the mud
 fluid was placed and the method or methods used in introducing it into the hold. If cement
 or other plugs were used, state the character of same and depth placed, from _____ feet
 to _____ feet for each plug set.

Dumped sand to 4050' and five (5) sacks cement.
Shot pipe at 3240'.
Pulled one hundred two (102) joints of 5 1/2" casing.
Squeezed well with fifteen (15) sacks gel, six (6) sacks
hulls, ten (10) sacks gel, one hundred (100) sacks 50/50
pozmix cement with 3% calcium chloride.


(If additional description is necessary, use BACK of this sheet)

Name of Plugging Contractor Rockhold Engineering, Inc.

STATE OF KANSAS COUNTY OF BARTON, ss.
James W. Rockhold (employee of owner) or (owner or operator) of the
 above-described well, being first duly sworn on oath, says: That I have knowledge of the
 facts, statements, and matters herein contained and the log of the above-described well as
 filed and that the same are true and correct. So help me God.

(Signature) James W. Rockhold
 JAMES W. ROCKHOLD - Box 698 - Great Bend, Ks.
 (Address) 67530

SUBSCRIBED AND SWORN TO before me this 15th day of March 1983

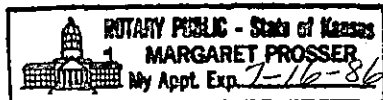

My Commission expires:

Margaret Prosser
 Notary Public:
 STATE CORPORATION COMMISSION
 RECEIVED
 MAR 21 1983

15-095-20144-0000

STATE OF KANSAS
STATE CORPORATION COMMISSION
200 Colorado Derby Bldg.
Wichita, Kansas 67202

Form CP-4
Rev. 12-15-80

WELL PLUGGING RECORD

Give All Information Completely
Make Required Affidavit

COUNTY Kingman SEC. 12 TWP. 30 RGE. 7 E/W
Location as in quarters or footage from lines:
C/NE/NE

Lease Owner Petroleum, Inc.
Lease Name Messenger "Q" Well No. #3
Office Address Box 1447 - Great Bend, Ks. 67530
Character of Well (Completed as Oil, Gas or Dry Hole): Oil
Date Well Completed _____
Application for plugging filed _____
Plugging commenced March 3, 1983
Plugging completed March 10, 1983
Reason for abandonment of well or producing formation
Depleted

Locate Well
correctly on above
Section Platt.

Was permission obtained from the Conservation Division or it's
Agent's before plugging was commenced? Yes

Name of Conservation Agent who supervised plugging of this well Maurice Leslie
Producing formation _____ Depth to top _____ bottom T.D. 4111'
Show depth and thickness of all water, oil and gas formations.

OIL, GAS OR WATER RECORDS

Casing Record

Formation	Content	From	To	Size	Put in	Pulled Out
				8 5/8"	250'	NONE
				5 1/2"	4097'	3273.97'

Describe in detail the manner in which the well was plugged, indicating where the mud
fluid was placed and the method or methods used in introducing it into the hold. If cement
or other plugs were used, state the character of same and depth placed, from _____ feet
to _____ feet for each plug set.

Dumped sand to 4050' and five (5) sacks cement.
Shot pipe at 3240'.
Pulled one hundred two (102) joints of 5 1/2" casing.
Squeezed well with fifteen (15) sacks gel, six (6) sacks
hulls, ten (10) sacks gel, one hundred (100) sacks 50/50
pozmix cement with 3% calcium chloride.

(If additional description is necessary, use BACK of this sheet)
Name of Plugging Contractor Rockhold Engineering, Inc.

STATE OF KANSAS COUNTY OF BARTON, ss.
James W. Rockhold (employee of owner) or (owner or operator) of the
above-described well, being first duly sworn on oath, says: That I have knowledge of the
facts, statements, and matters herein contained and the log of the above-described well as
filed and that the same are true and correct. So help me God.

(Signature) James W. Rockhold
JAMES W. ROCKHOLD - Box 698 - Great Bend, Ks.
(Address) 67530

SUBSCRIBED AND SWORN TO before me this 15th day of March, 1983



My Commission expires

Margaret Prosser
Notary Public:
RECEIVED
STATE CORPORATION COMMISSION
MAR 16 1983
CONSERVATION DIVISION
Wichita, Kansas

15-095-20144-0000

WELL LOG

COMPANY

Petroleum, Inc.

SEC. 12 T. 30S R. 7W

FARM

Messenger

NO. Q-3

LOC. C NE NE

TOTAL DEPTH

4111'

COUNTY Kingman Co., Kansas

COMM.


3-8-69

COMP.

3-17-69

CONTRACTOR

Garvey Drilling Company

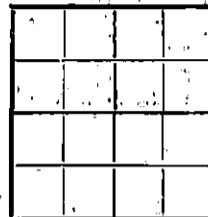

CASING

8 5/8" @ 250' w/185 SX

5 1/2" @ 4097' w/100 SX

ELEVATION

1496' KD

PRODUCTION

MISSISSIPPI

FIGURES INDICATE BOTTOM OF FORMATIONS

64' Clay & Lime
 250' Shale
 280' Red Bed
 990' Red Bed, Lime & Shale
 3685' Shale & Lime
 3835' Lime
 4080' Lime & Shale
 4094' Shale
 4111' Chert
 4111' RTD

RECEIVED
STATE COOPERATION COMMISSION

JAN 20 1969

CONSERVATION DIVISION
Wichita Kansas

State of Kansas

County of Barton

as

I, Eunice McEachern

of

Garvey Drilling Company

upon oath state the above and foregoing is a true and correct copy of the log of the Messenger No. Q-3 well.

Eunice McEachern

Subscribed and sworn to before me this 21st day of March 19 69

My Commission Expires: November 5th, 1969

Richard Day
NOTARY PUBLIC