

etc


STATE OF KANSAS  
STATE CORPORATION COMMISSION  
Give All Information Completely  
Make Required Affidavit  
Mail or Deliver Report to:  
Conservation Division  
State Corporation Commission  
211 No. Broadway  
Wichita, Kansas

WELL PLUGGING RECORD

Kingman County, Sec. 11 Twp. 30S Rge. 17W (E) (W)

Location as "NE/CNW\*SW\*" or footage from lines NE NE NW  
Lease Owner Sunray Mid-Continent Oil Company  
Lease Name Menno Kaufman Well No. 1  
Office Address 321 West Douglas - Wichita, Kansas  
Character of Well (completed as Oil, Gas or Dry Hole) Dry Hole  
Date well completed June 23 19 61  
Application for plugging filed June 27 19 61  
Application for plugging approved June 23 19 61  
Plugging commenced June 24 19 61  
Plugging completed June 24 3 A.M. 19 61  
Reason for abandonment of well or producing formation Dry

NORTH

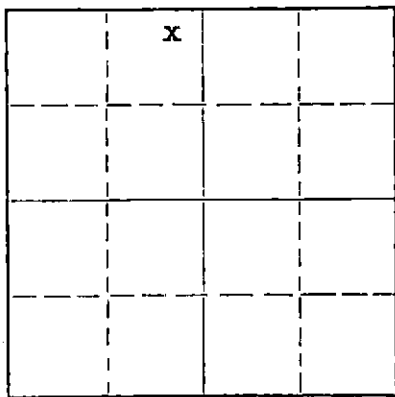

Locate well correctly on above Section Plat

If a producing well is abandoned, date of last production None 19  
Was permission obtained from the Conservation Division or its agents before plugging was commenced? Yes

Name of Conservation Agent who supervised plugging of this well Fred W. Hampel  
Producing formation None Depth to top Bottom Total Depth of Well 4225 Feet  
Show depth and thickness of all water, oil and gas formations.

OIL, GAS OR WATER RECORDS

CASING RECORD

FORMATION	CONTENT	FROM	TO	SIZE	PUT IN	PULLED OUT
Lansing, K.C.	Salt Water	3300	3840	8-5/8"	263'	0
Mississippi	Salt Water	4120	T.D.			

Describe in detail the manner in which the well was plugged, indicating where the mud fluid was placed and the method or methods used in introducing it into the hole. If cement or other plugs were used, state the character of same and depth placed, from feet to feet for each plug set.

Filled hole with mud to 240'. Set wood plug and 1/2 sack hulls and 30 sacks cement.  
Filled hole with mud to 40'; 1/2 sack hulls and wood plug w/ 15 sack cement plug to surface - filled rat hole w/ 5 sacks cement.

RECEIVED  
STATE CORPORATION COMMISSION

JUL 14 1961

CONSERVATION DIVISION  
Wichita, Kansas

(If additional description is necessary, use BACK of this sheet)

Name of Plugging Contractor Stickle Drilling Company  
Address Wichita, Kansas

STATE OF Kansas, COUNTY OF Sedgwick, ss.  
Nash A. Gough (employee of owner) of the above-described well, being first duly sworn on oath, says: That I have knowledge of the facts, statements, and matters herein contained and the log of the above-described well as filed and that the same are true and correct. So help me God.

(Signature) Nash A. Gough  
321 W. Douglas, Wichita, Kansas  
(Address)

SUBSCRIBED AND SWORN TO before me this 13 day of July, 19 61

My commission expires July 13, 1963

[Signature] Notary Public.

INVOICED

DATE  
INV. NO.

WELL LOG BUREAU—KANSAS GEOLOGICAL SOCIETY  
508 East Murdock, Wichita, Kansas


COPY

Company. SUNRAY MID-CONTINENT OIL CO.  
Farm. Menno Kaufman No. 1

SEC. 11 T. 30 R. 7W  
NE NE NW

Total Depth. 4225'  
Comm. 6-12-61 Comp. 6-24-61  
Shot or Treated.  
Contractor. Stickle Drig.  
Issued. 1-13-62

County Kingman  
KANSAS

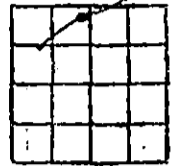

CASING:  
8" 263'

Elevation. 1475'

Production. Dry

Figures Indicate Bottom of Formations.

sand	40
shale & shells	630
shale	1050
lime & shale	1280
shale & lime	1450
lime	1750
lime & shale	1765
shale	2045
lime & shale	2365
shale & shells	2610
shale	2750
lime & shale	2970
shale	3065
lime	3930
lime & shale	4020
shale	4110
Conglomerate	4123
lime & chert	4164
chert	4185
chert & lime	4225
Total Depth	

TOPS: SCOUT	
Heebner	3081
Douglas	3119
Lansing	3302
Cherokee Shale	3995
Mississippi	4166