


15-095-01349-0000

STATE OF KANSAS  
CORPORATION COMMISSION

Give All Information Completely  
Make Required Affidavit  
Mail or Deliver Report to:  
Conservation Division  
State Corporation Commission  
211 No. Broadway  
Wichita, Kansas

WELL PLUGGING RECORD

NORTH

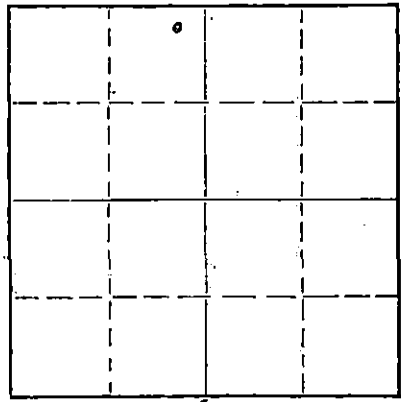

Locate well correctly on above  
Section Plat

Kingman County, Sec. #10 Twp 30S Rge. 7W (E) (W)  
Location as "NE/CNW/SW" or footage from lines NE NE NW  
Lease Owner Mull Drilling, Co. Inc.  
Lease Name Love Well No. 2  
Office Address 670 N 1/2th. Natl. Bank Bldg. Wichita, Kansas  
Character of Well (completed as: Oil, Gas or Dry Hole) Dry Hole.  
Date well completed 5-19-62 19\_\_  
Application for plugging filed 5-19-62 19\_\_  
Application for plugging approved 5-19-62 19\_\_  
Plugging commenced 5-19-62 19\_\_  
Plugging completed 5-19-62 19\_\_  
Reason for abandonment of well or producing formation \_\_\_\_\_  
Non productive.  
If a producing well is abandoned, date of last production \_\_\_\_\_ 19\_\_  
Was permission obtained from the Conservation Division or its agents before plugging was commenced? Yes.

Name of Conservation Agent who supervised plugging of this well Fred Hampel  
Producing formation \_\_\_\_\_ Depth to top \_\_\_\_\_ Bottom \_\_\_\_\_ Total Depth of Well 4217' Feet  
Show depth and thickness of all water, oil and gas formations.

OIL, GAS OR WATER RECORDS

CASING RECORD

FORMATION	CONTENT	FROM	TO	SIZE	PUT IN	PULLED OUT

Describe in detail the manner in which the well was plugged, indicating where the mud fluid was placed and the method or methods used in introducing it into the hole. If cement or other plugs were used, state the character of same and depth placed, from \_\_\_\_\_ feet to \_\_\_\_\_ feet for each plug set.

Hole filled with drilling mud to within 220' of top of surface. Plug put at this depth with 1/4 sack hulls added and 20 sacks cement put on top of plug and hulls.  
Hole was then filled to within 40' of surface and a plug put at this depth with 1/4 sack hulls and 10 sacks cement added. This filled surface casing. Two sacks cement was put in rat hole bridging same and completing plugging of well.

RECEIVED  
STATE CORPORATION COMMISSION  
MAY 25 1962  
5-25-62  
CONSERVATION DIVISION  
Wichita, Kansas

Name of Plugging Contractor Co. tools. (If additional description is necessary, use BACK of this sheet)  
Address 670 N. 1/2th. Natl. Bank Bldg. Wichita, Kansas


STATE OF KANSAS, COUNTY OF SEDGWICK, ss.  
Joseph O. Butts (employee of owner) or (owner or operator) of the above-described well, being first duly sworn on oath, says: That I have knowledge of the facts, statements, and matters herein contained and the log of the above-described well as filed and that the same are true and correct. So help me God.

(Signature) Joseph O. Butts  
Wichita, Kansas  
(Address)

SUBSCRIBED AND SWORN TO before me this 21st day of May, 19 62

My commission expires October 16, 1965

Bettie H. Salter  
Notary Public.

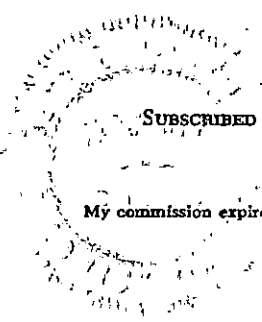

ROTARY DRILLERS LOG

COMPANY: Mull Drilling Co., Inc. et al      ROTARY DRILLING COMMENCED: 5/ 9/62  
 Wichita, Kansas

CONTRACTOR: Mull Drilling Co., Inc.      ROTARY DRILLING COMPLETED: 5/20/62  
 Wichita, Kansas

CASING RECORD: Set 224' of 8-5/8" csg.      LOCATION: LOVE #2  
 w/ 125 sx. cement      NE NE NW 10-30S-7W  
 D & A      Kingman County, Kansas

(Figures indicate bottom of formation - measurements from top of Rotary Bushing)

1150'	Red bed & shale
1410'	Shale & lime
1805'	Lime & shale
2300'	Shale & lime
3285'	Shale & sandy lime
3364'	Sandy lime & shale
3532'	Lime & shale
3643'	Sandy lime w/ shale
3740'	Shale & lime
3831'	Lime & shale
3920'	Shale w/ lime
4128'	Lime & shale
4150'	Shale & Miss.
4217'	Miss. - Total Depth

**RECEIVED**  
 STATE CORPORATION COMMISSION  
 5-25-62  
 MAY 25 1962  
 CONSERVATION DIVISION  
 Wichita, Kansas

I hereby certify that this is a true and correct copy of the above log to the best of my knowledge.

MULL DRILLING COMPANY, INC.

*Delbert J. Costa*  
 Delbert J. Costa, Geologist

STATE OF KANSAS      )  
                                   )      SS  
 COUNTY OF SEDGWICK    )

and sworn to before me this 24th day of May, 1962.



*Madge M. Miller*  
 Madge M. Miller      Notary Public

Expires: February 24, 1964