


STATE OF KANSAS  
STATE CORPORATION COMMISSION

WELL PLUGGING RECORD

Give All Information Completely  
Make Required Affidavit  
Mail or Deliver Report to:  
Conservation Division  
State Corporation Commission  
212 North Market, Insurance Bldg.  
Wichita, Kansas

Kingman County. Sec. 8, Twp. 30 Rge. 7 (E) W (W)  
Location as "NE/CNW/SW" or footage from lines. NE SE SW  
Lease Owner Pickrell Drilling Company  
Lease Name Kohman "B" Well No. 1  
Office Address 705 Fourth Nat'l. Bank Bldg.; Wichita, Kansas  
Character of Well (completed as Oil, Gas or Dry Hole) Dry Hole  
Date well completed 5-27 1959  
Application for plugging filed 5-27 1959  
Application for plugging approved 5-27 1959  
Plugging commenced 5-27 1959  
Plugging completed 5-27 1959  
Reason for abandonment of well or producing formation D & A

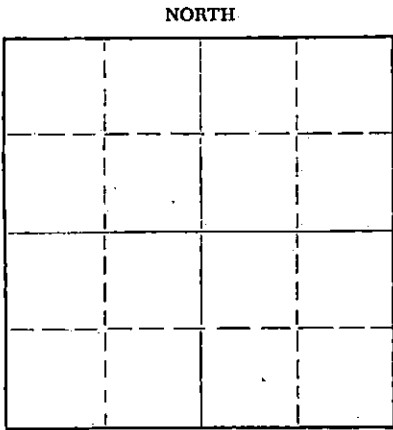

Locate well correctly on above Section Plat

If a producing well is abandoned, date of last production 19  
Was permission obtained from the Conservation Division or its agents before plugging was commenced? Yes

Name of Conservation Agent who supervised plugging of this well W. L. Lackamp  
Producing formation \_\_\_\_\_ Depth to top \_\_\_\_\_ Bottom \_\_\_\_\_ Total Depth of Well 4259 Feet  
Show depth and thickness of all water, oil and gas formations.

OIL, GAS OR WATER RECORDS

CASING RECORD

FORMATION	CONTENT	FROM	TO	SIZE	PUT IN	PULLED OUT
				8 5/8"	250'	None

Describe in detail the manner in which the well was plugged, indicating where the mud fluid was placed and the method or methods used in introducing it into the hole. If cement or other plugs were used, state the character of same and depth placed, from \_\_\_\_\_ feet to \_\_\_\_\_ feet for each plug set.

Filled with heavy mud to 240', bridge hole and cement with 20 sacks cement.  
Then heavy mud to 40' below ground level, bridge hole and cement with 10  
sacks cement to bottom of cellar

RECEIVED  
STATE CORPORATION COMMISSION  
JUN 12 1959  
CONSERVATION DIVISION  
WICHITA, KANSAS

(If additional description is necessary, use BACK of this sheet)  
Name of Plugging Contractor Pickrell Drilling Company  
Address 705 4th Nat'l. Bank Bldg., Wichita, Kansas

STATE OF KANSAS, COUNTY OF SEDGWICK, ss.  
C. W. SEBITS (employee of owner) or (owner or operator) of the above-described well, being first duly sworn on oath, says: That I have knowledge of the facts, statements, and matters herein contained and the log of the above-described well as filed and that the same are true and correct. So help me God.

(Signature) [Signature]  
705 4th Nat'l. Bank Bldg., Wichita, Kansas  
(Address)

SUBSCRIBED AND SWORN to before me this 10 day of June, 19 59.

My commission expires August 14, 1961  
Ruth M. Sullivan (Ruth Sullivan) Notary Public.

PLUGGING  
FILE SEC. 8 T. 30 R. 7W  
BOOK PAGE 75 LINE 1

COMPANY: Pickrell Drilling Company  
 Rotary Drilling Commenced 2/23/59  
 Rotary Drilling Completed 5/27/59

LOCATION: NE SE SW Sec. 8-20-7W  
 Kingman County, Kansas  
 KOMMAN "B" #1

CONTRACTOR: PICKRELL DRILLING COMPANY  
 Wichita, Kansas

CASING RECORD: 250' 8 5/8" 36# casing cemented with 160 sacks cement 2% cc  
 Cement circulated  
 D & A (No oil string run)

LOG

(Figures indicate bottom of formation — measurements from top of rotary bushing.)

Red rock & shale	640'	Circulate for samples:
Shale, shells & lime	1310'	3784'
Lime	1460'	4125'
Lime & shale	1755'	4130'
Shale	1990'	4142'
Shale & lime	2714'	4170'
Lime	2830'	4259'
Lime, shale & sand	3340'	
Shale & lime	3415'	
Lime	3511'	
Lime & shale	3595'	
Lime	3784'	
Lime & shale	4119'	
Mississippi	4259'	T.D.

S.L.M. @ 2000' - OK  
 3000' - OK  
 4000' - OK

Slope Test @ 2000' 0° off  
 3000' 0° off  
 4000' 0° off

RECEIVED  
 STATE CORPORATION COMMISSION

JUN 25 1959

CONSERVATION DIVISION  
 Wichita, Kansas

The undersigned, C. W. Sebitts, Attorney-in-Fact for PICKRELL DRILLING COMPANY, hereby certifies in behalf of said Company, that the above is a true and correct log of the formation encountered in drilling the above well as reflected by the Daily Drilling Reports.

PICKRELL DRILLING COMPANY  
 By [Signature]  
 Attorney-in-Fact

STATE OF KANSAS }  

On this 10 day of June, 1959, before me the undersigned, a Notary Public, in and for the County and State aforesaid, personally appeared C. W. Sebitts, to me known to be the identical person who subscribed the name of PICKRELL DRILLING COMPANY to the foregoing instrument as its Attorney-in-Fact and acknowledged to me that he executed the same as his free and voluntary act and deed, and as the free and voluntary act and deed of such company, for the uses and purposes therein set forth.

Given under my hand and seal of office the day and year last above written.

My commission expires: August 14, 1961

PLUGGING  
 FILE SEC. 8 T. 30 R. 7W  
 BOOK PAGE 45 LINE 1

[Signature]  
 Notary Public  
 Sullivan