


STATE OF KANSAS  
STATE CORPORATION COMMISSION

Form CP-4

Give All Information Completely  
Make Required Affidavit  
Mail or Deliver Report to:  
Conservation Division  
State Corporation Commission  
P. O. Box 17027  
Wichita, Kansas 67217  
NORTH

WELL PLUGGING RECORD

Kingman County Sec. 8 Twp. 30 Rge. 7 (E) W (W)  
Location as "NE/CNW/SW" or footage from lines NW NW NW  
Lease Owner Pickrell Drlg. Co.  
Lease Name Kohman 'D'  
Office Address 705 Fourth Nat'l Bank Bldg., Wichita, Ks. 67202  
Character of Well (completed as Oil, Gas or Dry Hole) Oil  
Date well completed May 31 19 61  
Application for plugging filed October 27 19 72  
Application for plugging approved October 28 19 72  
Plugging commenced November 11 19 72  
Plugging completed November 27 19 72  
Reason for abandonment of well or producing formation Depleted

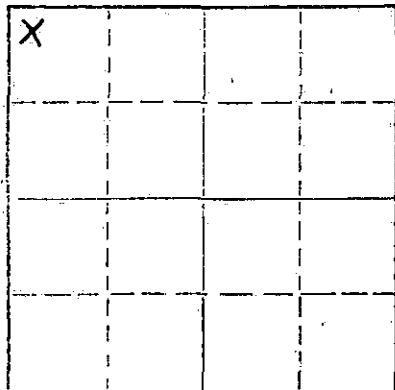

Locate well correctly on above  
Section Plat

If a producing well is abandoned, date of last production October 26 19 72  
Was permission obtained from the Conservation Division or its agents before plugging was commenced? Yes

Name of Conservation Agent who supervised plugging of this well Russell Biberstein  
Producing formation Mississippian Depth to top 4122 Bottom 4398 Total Depth of Well 4562 Feet  
Show depth and thickness of all water, oil and gas formations.

OIL, GAS OR WATER RECORDS

CASING RECORD

FORMATION	CONTENT	FROM	TO	SIZE	PUT IN	PULLED OUT
				8 5/8"	505	None
				5 1/2	4558	3620

Describe in detail the manner in which the well was plugged, indicating where the mud fluid was placed and the method or methods used in introducing it into the hole. If cement or other plugs were used, state the character of same and depth placed, from \_\_\_\_\_ feet to \_\_\_\_\_ feet for each plug set.

November 11, 1972 Plugged off bottom. Dumped sand to 4100'. Mixed and dumped 5 sx of cement.  
November 27, 1972 Plugged off top. Set 15' rock bridge at 380'. Filled 8 5/8" surface casing from 380' to base of cellar with 3000 lb. P.S.I. ready-mix concrete.

RECEIVED  
STATE CORPORATION COMMISSION  
DEC 1 - 1972  
CONSERVATION DIVISION  
Wichita, Kansas


(If additional description is necessary, use BACK of this sheet)  
Name of Plugging Contractor RUSS CASING PULLING, INC.  
Address P. O. Box 1082 ; Great Bend, Kansas 67530

STATE OF Kansas COUNTY OF Sedgwick, ss.  
Dale M. Robinson (employee of owner) or (owner or operator) of the above-described

well, being first duly sworn on oath, says: That I have knowledge of the facts, statements, and matters herein contained and the log of the above described well as filed and that the same are true and correct. So help me God.

(Signature) Dale M. Robinson  
705 Fourth National Bank Bldg., Wichita, Kansas (Address)

Subscribed and sworn to before me this 6th day of December, 1972

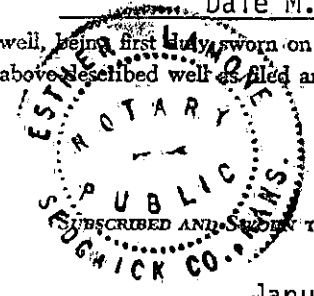

Esther Lamone  
Notary Public.

My commission expires January 19, 1973

15-095-01181-0000

ROTARY DRILLING LOG

COMPANY: Pickrell Drilling Company  
705 Fourth National Bank Bldg.  
Wichita 2, Kansas

Rotary Drilling Commenced 4/19/61

Rotary Drilling Completed 5/6/61

LOCATION: KOHMAN C #1 - NW NW NW  
Sec 8-30S-7W  
Kingman County, Kansas

CONTRACTOR: PICKRELL DRILLING COMPANY  
Wichita, Kansas

CASING RECORD: 505' (11 jts.) 8 5/8" 20# Surface Casing with 275 sacks cement.  
Cement Circulated.

Ran 145 jts., 5 1/2" casing. Set @ 4558'. Cemented with 100 sacks cement,  
completed 4:15 a.m., May 6, 1961

LOG

(Figures indicate bottom of formation — measurements from top of rotary bushing.)

	<u>Circulated for Samples</u>
400'	Red Rock & Shale 4132'
505'	Red Rock 4142'
1065'	Shale, Gyp, Clay & Salt 4152'
1375'	Shale, Shells & Lime 4162'
1860'	Lime 4172'
3018'	Lime & Shale 4182'
3370'	Sand, Shale & Lime 4192'
3861'	Lime 4202'
4122'	Lime & Shale 4490'
4418'	Mississippi 4495'
4484'	Lime & Shale 4500'
4510'	Shale 4505'
4525'	Viola 4515'
4537'	Lime & Dolomite 4520'
4560'	Simpson T.D. 4525'
	4560'

<u>Slope Test</u>	
1375'	0°
2405'	0°
3861'	0°
4484'	0°

S. L. M.

2240'  
3437'  
4270'

RECEIVED  
STATE CORPORATION COMMISSION  
MAY 30 1962  
CONSERVATION DIVISION  
Wichita, Kansas

The undersigned, Gerald W. Pike, Attorney-in-Fact for PICKRELL DRILLING COMPANY, hereby certifies in behalf of said Company, that the above is a true and correct log of the formation encountered in drilling the above well as reflected by the Daily Drilling Reports.

PICKRELL DRILLING COMPANY

By Gerald W. Pike  
Attorney-in-Fact  
Gerald W. Pike

STATE OF KANSAS }  
COUNTY OF SEDGWICK } ss.:

On this 22nd day of May, 1961, before me the undersigned, a Notary Public, in and for

the County and State aforesaid, personally appeared Gerald W. Pike, to me known to be the identical person who subscribed the name of PICKRELL DRILLING COMPANY to the foregoing instrument as its Attorney-in-Fact and acknowledged to me that he executed the same as his free and voluntary act and deed, and as the free and voluntary act and deed of such company, for the uses and purposes therein set forth.

Given under my hand and seal of office the day and year last above written.

My commission expires: September 24, 1962

Maxine Johnson  
Notary Public  
Maxine Johnson