


STATE OF KANSAS  
STATE CORPORATION COMMISSION

Form CP-4

WELL PLUGGING RECORD

Give All Information Completely  
Make Required Affidavit  
Mail or Deliver Report to:  
Conservation Division  
State Corporation Commission  
212 No. Market  
Wichita, Kansas 67202

NORTH

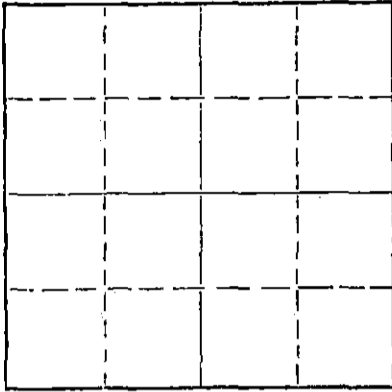

Locate well correctly on above  
Section Plat

Kingman County, Sec. 8 Twp. 35S Rge. ~~6~~ 7 (W)  
Location as "NE/CNW/SW" or footage from lines NE SW NW  
Lease Owner Pickrell Drilling Company  
Lease Name Kohman "D" Well No. 2  
Office Address 705 Fourth National Bank Building, Wichita, Kansas 67202  
Character of Well (completed as Oil, Gas or Dry Hole) Dry Hole  
Date well completed August 11 19 70  
Application for plugging filed August 11 19 70  
Application for plugging approved August 11 19 70  
Plugging commenced August 11 19 70  
Plugging completed August 11 19 70  
Reason for abandonment of well or producing formation Dry Hole

If a producing well is abandoned, date of last production 19  
Was permission obtained from the Conservation Division or its agents before plugging was commenced? Yes

Name of Conservation Agent who supervised plugging of this well G. Russell Biberstein  
Producing formation Depth to top Bottom Total Depth of Well 4514 Feet  
Show depth and thickness of all water, oil and gas formations.

OIL, GAS OR WATER RECORDS

CASING RECORD

FORMATION	CONTENT	FROM	TO	SIZE	PUT IN	PULLED OUT
				8-5/8"	209'	None

Describe in detail the manner in which the well was plugged, indicating where the mud fluid was placed and the method or methods used in introducing it into the hole. If cement or other plugs were used, state the character of same and depth placed, from feet to feet for each plug set.

Plug # 1 @ 200' w/25 sacks, plug # 2 @ 40' w/10 sacks cement and 1/2 sack hulls.

RECEIVED  
STATE CORPORATION COMMISSION  
AUG 18 1970  
CONSERVATION DIVISION  
Wichita, Kansas

(If additional description is necessary, use BACK of this sheet)  
Name of Plugging Contractor Pickrell Drilling Company  
Address 705 Fourth National Bank Building, Wichita, Kansas 67202

STATE OF Kansas, COUNTY OF Sedgwick, ss.  
C. W. Sebitts (employee of owner) or (owner or operator) of the above-described well, being first duly sworn on oath, says: That I have knowledge of the facts, statements, and matters herein contained and the log of the above-described well as filed and that the same are true and correct. So help me God.

(Signature) C. W. Sebitts  
705 Fourth National Bank Bldg, Wichita, Kansas (Address)

Subscribed and Sworn to before me this 13th day of August, 19 70



Esther Lamone  
Notary Public.

**ROTARY DRILLING LOG**

**COMPANY:** Pickrell Drilling Company  
705 Fourth National Bank Building  
Wichita, Kansas 67202

Rotary Drilling Commenced 7/30/70

**LOCATION:** Kohman "D" No. 2, NE SW NW Section 8-30S-7W  
Kingman County, Kansas

Rotary Drilling Completed 8/11/70

**CONTRACTOR:** **PICKRELL DRILLING COMPANY**  
Wichita, Kansas

**CASING RECORD:** Run 10 Jts. 8-5/8" surface casing set @ 209' KB. Cemented with 140 sacks cement. Completed 9:15 PM July 30, 1970. Circulated.

No oil string run. D & A, Plugged 10:30 PM August 11, 1970.

**LOG**

(Figures indicate bottom of formation — measurements from top of rotary bushing.)

209	Red Rock	C.F.S.
380	Red Rock & Shale	3365
1070	Shale	3750
1230	Shale & Lime Stringers	3780
1530	Lime & Shale	3808
1745	Shale & Lime	4135
1925	Lime & Shale	4165
3110	Shale	4480
3228	Shale & Lime	4490
3355	Shale	4498
3506	Shale & Lime	4502
3585	Lime & Shale	4507
3644	Shale & Lime	4514
3808	Lime & Shale	
3835	Lime	
3935	Lime & Shale	
4005	Shale & Lime Shale	Slope Tests
4042	Lime & Shale	2000
4165	Shale & Lime	2500
4218	Miss., Cherty Dolomite	3000
4276	Mississippian	3500
4371	Lime	4000
4498	Lime & Shale	4500
4500	Shale	
4502	Misener	
4514	Viola, RTD	

RECEIVED  
STATE CORPORATION COMMISSION  
AUG 18 1970  
CONSERVATION DIVISION  
Wichita, Kansas

The undersigned, C. W. Sebitts, Attorney-in-Fact for PICKRELL DRILLING COMPANY, hereby certifies in behalf of said Company, that the above is a true and correct log of the formation encountered in drilling the above well as reflected by the Daily Drilling Reports.

PICKRELL DRILLING COMPANY

By [Signature]  
C. W. Sebitts Attorney-in-Fact

STATE OF KANSAS }  
COUNTY OF SEDGWICK } ss.:

On this 13th day of August, 19 70, before me the undersigned, a Notary Public, in and for

the County and State aforesaid, personally appeared C. W. Sebitts, to me known to be the identical person who subscribed the name of PICKRELL DRILLING COMPANY to the foregoing instrument as its Attorney-in-Fact and acknowledged to me that he executed the same as his free and voluntary act and deed, and as the free and voluntary act and deed of such company, for the uses and purposes therein set forth.

Given under my hand and seal of office the day and year last above written.

My Commission expires: January 19, 1973

[Signature]  
Esther Lamone Notary Public

