


STATE OF KANSAS
STATE CORPORATION COMMISSION

15-119-20620-00-00
(Lost Hole)

WELL PLUGGING RECORD

Give All Information Completely
Make Required Affidavit
Mail or Deliver Report to
Conservation Division
State Corporation Comm.
245 North Water
Wichita, KS 67202

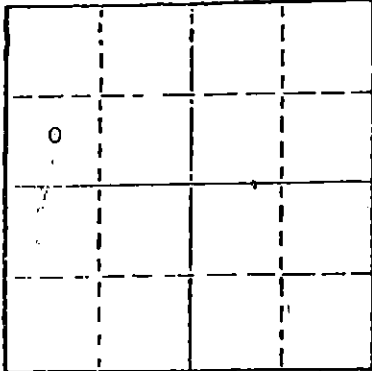

Locate well correctly on above
Section Plat

Meade County, Sec. 9 Twp. 31S Rge. 30 E/W
Location as "NE/CNW $\frac{1}{4}$ SW $\frac{1}{4}$ " or footage from lines
C SW/4 NW/4
Lease Owner Calvin Exploration, Inc.
Lease Name Hobart Well No. 1-9
Office Address 1125 17th St., Denver, CO 80202
Character of Well (Completed as Oil, Gas or Dry Hole)
Dry Hole
Date Well completed June 9, 19 83
Application for plugging filed Verbal 19
Application for plugging approved " 19
Plugging commenced June 8, 19 83
Plugging completed June 8, 19 83
Reason for abandonment of well or producing formation
Lost drilling equipment in hole
If a producing well is abandoned, date of last production
N/A 19

Was permission obtained from the Conservation Division or
its agents before plugging was commenced? Yes

Name of Conservation Agent who supervised plugging of this well Bob Tarburn
Producing formation N/A Depth to top - Bottom - Total Depth of Well 1520'
Show depth and thickness of all water, oil and gas formations.

OIL, GAS OR WATER RECORDS

CASING RECORD

FORMATION	CONTENT	FROM	TO	SIZE	PUT IN	PULLED OUT
Surface sands	Sand	-	-	20"	75'	-0-

Describe in detail the manner in which the well was plugged, indicating where the mud fluid was placed and the method or methods used in introducing it into the hold. If cement or other plugs were used, state the character of same and depth placed, from 520 feet to 3 feet for each plug set. Cement plug was placed from 520' by gradually removing drill pipe up the hole and pumping cement all the way to the surface 3'. Fish left in hole was 16' drill collars and 18 joints of drill pipe.

(If additional description is necessary, use BACK of this sheet)

Name of Plugging Contractor DaMac Drilling Co. - Halliburton

STATE OF COLORADO

COUNTY OF DENVER

, ss.

S. P. Bickley

(employee of owner) or (owner/bk/operation)

of the above-described well, being first duly sworn on oath, says: That I have knowledge of the facts, statements, and matters herein contained and the log of the above-described well as filed and that the same are true and correct. So help me God.

(Signature)

S. P. Bickley, Jr.
S. Peter Bickley, Jr.
1125 17th St., Denver, CO 80202
(Address)

SUBSCRIBED AND SWORN TO before me this 15th day of June, 19 83

Elizabeth A. Hatcher
Elizabeth A. Hatcher - Notary Public.

My commission expires

March 7, 1984
STATE CORPORATION COMMISSION

JUN 20 1983

CONSERVATION DIVISION
Wichita, Kansas