


WELL PLUGGING RECORD

Give All Information Completely
Make Required Affidavit
Mail or Deliver Report to:
Conservation Division
State Corporation Commission
211 No. Broadway
Wichita, Kansas

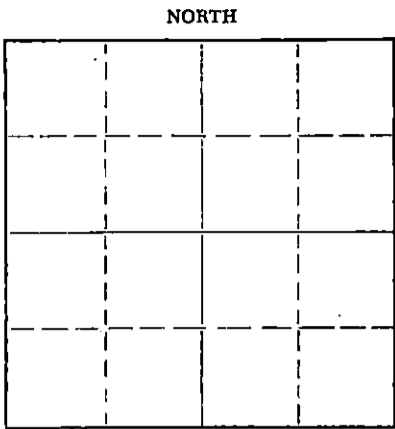

Locate well correctly on above Section Plat

Clark County. Sec. 4 Twp. 31 Rge. 21 (W)
Location as "NE/CNWSW" or footage from lines C/NE/SW
Lease Owner Great Bend Pipe and Supply Company
Lease Name F.L. Dailey Well No. #1
Office Address West 10th, Box 414, Great Bend, Kansas
Character of Well (completed as Oil, Gas or Dry Hole)
Date well completed 19
Application for plugging filed Yes 19
Application for plugging approved Yes 19
Plugging commenced 9-22 19 57
Plugging completed 9-28 19 57
Reason for abandonment of well or producing formation

If a producing well is abandoned, date of last production 19
Was permission obtained from the Conservation Division or its agents before plugging was commenced? Yes

Name of Conservation Agent who supervised plugging of this well Mr. M.A. Rives
Producing formation Depth to top Bottom Total Depth of Well 5254' Feet
Show depth and thickness of all water, oil and gas formations.

OIL, GAS OR WATER RECORDS					CASING RECORD	
FORMATION	CONTENT	FROM	TO	SIZE	PUT IN	PULLED OUT
				5 1/2"		3,788'

Describe in detail the manner in which the well was plugged, indicating where the mud fluid was placed and the method or methods used in introducing it into the hole. If cement or other plugs were used, state the character of same and depth placed, from feet to feet for each plug set.

Measured into T.D. 5254'.
Plugging started 9-22-57. Finished 9-28-57.
Plugged off bottom with sand to 5180' and dumped 5 sacks cement.
Shot 5 1/2" pipe at 3,788'. Worked and started pipe. Built rack and slide. Layed down pipe. Cleaned out cellar for welder to cut off head. Measured in on cement. Mud to 20'. Set rock bridge and dumped 20 sacks cement for cap on well. Well completed.

(If additional description is necessary, use BACK of this sheet)
Name of Plugging Contractor J.O. Forbes d/b/a Forbes Casing Pulling Co.
Address Box 221, Great Bend, Kansas

STATE OF Kansas, COUNTY OF Barton, ss.
J.O. Forbes (employee of owner) or (owner or operator) of the above-described well, being first duly sworn on oath, says: That I have knowledge of the facts, statements, and matters herein contained and the log of the above-described well as filed and that the same are true and correct. So help me God.

(Signature) *J.O. Forbes*
Box 221, Great Bend, Kans.
(Address)

SUBSCRIBED AND SWORN TO before me this 30th day of September, 1957.

My commission expires November 8, 1960.
Betty E. Edman Notary Public.

PLUGGING
FILE SEC. 4 T. 31 R. 21W
BOOK PAGE 43 LINE 41

OCT 5 - 1957
CONSERVATION DIVISION
KANSAS

WELL LOG BUREAU—KANSAS GEOLOGICAL SOCIETY
508 East Murdock, Wichita, Kansas

15-025-00033-0000

COPY


Company- TRANS ERA PETROLEUM, INC.
Farm- F. L. Dailey No. 1

SEC. 4 T. 31 R. 21W
C NE SW

Total Depth. 5254'
Comm. 11-20-55 Comp. 12-20-55
Shot or Treated.
Contractor.
Issued. 3-24-56

County Clark

KANSAS

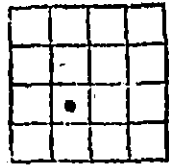

Elevation. 2221.10'

Production. Swab 30 BOFH in 4 hr test.

Figures indicate Bottom of Formations

sand & rock	50
rock	68
sand rock	73
shale grey	120
sand	135
red bed, shale & shells	355
red bed	410
red bed & shale	1225
anhydrite	1243
red bed & shale	1475
shale & shells	1775
shale & lime shells	1865
shale & shells	2070
salt & shale	2170
lime & shale	2400
shale & sand lime	2515
lime gyp pyrite	2590
shale & lime	3055
shale	3225
shale & lime	3311
shale - red & gray	3411
shale	3412
shale & lime	3925
lime	4006
lime & shale	4083
lime, shale & bentonite	4150
lime & shale	4542
lime	4603
lime & shale	4702
lime	4720
lime & shale	4757
lime	4800
lime & shale	4970
lime	5016
lime & shale	5254
Total Depth	

Tops:	
Heebner	4270
Toronto	4287
Base Lime	4452
Kansas City	4469
Base Kansas City	4929
Cherokee	5071
Mississippi	5169

PLUGGING
FILE SEC. 4 T. 31 R. 21W
BOOK PAGE 43 LINE 41

RECEIVED
STATE CORPORATION COMMISSION
SEP 10 1957
CONSERVATION DIVISION
Wichita, Kansas