


15-025-20110-0000

STATE OF KANSAS
STATE CORPORATION COMMISSION

WELL PLUGGING RECORD

Give All Information Completely
Make Required Affidavit
Mail or Deliver Report to
Conservation Division
State Corporation Comm.
245 North Water
Wichita, KS 67202

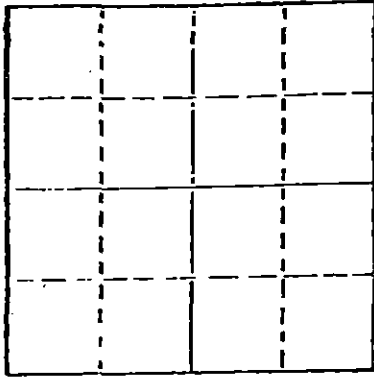

Locate well correctly on above Section Plot

Clark County, Sec. 5 Twp. 31S Rge. 21W E/W
Location as "NE/CNW $\frac{1}{4}$ SW $\frac{1}{4}$ " or footage from lines _____
C SE NW
Lease Owner D N B Drilling, Inc., & Ennex, Inc.
Lease Name Hinkle Well No. 1
Office Address 701 First Nat'l Bldg., Wichita, 67202
Character of Well (Completed as Oil, Gas or Dry Hole) _____
Dry Hole

Date Well completed 4-30 19 76
Application for plugging filed 4-30 19 76
Application for plugging approved 4-30 19 76
Plugging commenced 4-30 19 76
Plugging completed 4-30 19 76
Reason for abandonment of well or producing formation _____
No commercial quantities of oil or gas encountered.
If a producing well is abandoned, date of last production _____ 19 _____

Was permission obtained from the Conservation Division or its agents before plugging was commenced? Yes

Name of Conservation Agent who supervised plugging of this well Clarence Thomas
Producing formation _____ Depth to top _____ Bottom _____ Total Depth of Well 5360
Show depth and thickness of all water, oil and gas formations.

OIL, GAS OR WATER RECORDS

CASING RECORD

FORMATION	CONTENT	FROM	TO	SIZE	PUT IN	PULLED OUT
Surface Hole	Shale	Surf.	603	8-5/8"	595	None

Describe in detail the manner in which the well was plugged, indicating where the mud fluid was placed and the method or methods used in introducing it into the hold. If cement or other plugs were used, state the character of same and depth placed, from _____ feet to _____ feet for each plug set.

Fluid to 600', plug, 50 sx cement;
Fluid to 40', plug, 15 sx cement;
Five sacks cement in rat hole.

RECEIVED
STATE CORPORATION COMMISSION

MAY 6 1976
MAY 07 1976

JAMES L. DONELSON
WICHITA, KANSAS

(If additional description is necessary, use BACK of this sheet)
Name of Plugging Contractor D N B DRILLING, INC.
701 First National Building
Wichita, Kansas 67202

STATE OF KANSAS COUNTY OF _____ ss.
JAMES L. DONELSON (employee of owner) or (owner or operator) of the above-described well, being first duly sworn on oath, says: That I have knowledge of the facts, statements, and matters herein contained and the log of the above-described well as filed and that the same are true and correct. So help me God.

(Signature) James L. Donelson
701 First Nat'l Bldg., Wichita, Kansas 67202
(Address)

Subscribed and Sworn to before me this 5th day of May, 19 76

My commission expires 8-25-76

Ella Priess
Ella Priess Notary Public.

Ella Priess
STATE NOTARY PUBLIC
Sedgwick County, Kansas
My Com. Expires Aug. 25, 1976

DRILLERS' LOG

D N B DRILLING, INC.
and
ENNEX, Inc.
No. 1 Hinkle
C SE NW, Sec. 5-31S-21W
Clark County, Kansas

15-025-20110-0000

Elev: 2270 K.B.

Commenced: 4-16-76
Completed: 4-30-76

Surface Casing: 595' of
8-5/8" cemented w/200 sx
common cement 4% Gel +
200 sx common cement, 2% Gel,
3% cc. 4-17-76

FORMATION

DEPTH

Surface Hole	0 - 603
Red Bed	603 - 740
Red Bed & Shale	740 - 1630
Shale & Lime	1630 - 2430
Lime & Shale	2430 - 2680
Shale & Lime	2680 - 3150
Lime & Shale	3150 - 3390
Shale & Lime	3390 - 3626
Lime & Shale	3626 - 4070
Shale & Lime	4070 - 4185
Lime	4185 - 4280
Shale & Lime	4280 - 4420
Lime	4420 - 5235
Lime & Shale	5235 - 5295
Lime	5295 - 5360 RTD

I do hereby certify that the foregoing statements are true and correct to the best of my knowledge and belief.

D N B DRILLING, INC.

James L. Donelson
JAMES L. DONELSON

STATE OF KANSAS: ss:

Subscribed and sworn to before me this 5th day of May 1976.

Ella Priess

Ella Priess, Notary Public

<i>Ella Priess</i>
STATE NOTARY PUBLIC
Sedgwick County, Kansas
My Com. Expires Aug. 25, 1976