


STATE OF KANSAS
STATE CORPORATION COMMISSION

Give All Information Completely
Make Required Affidavit
Mail or Deliver Report to:
Conservation Division,
State Corporation Commission,
212 No. Market
Wichita, Kansas.

WELL PLUGGING RECORD

Pratt County, Sec. 23 Twp. 28 Rge. 12 (E) (W)
SW/C NE/4 SW/4

Location as "NE/CNW/SW" or footage from lines
Lease Owner Raymond Oil Co., Inc.
Lease Name Chitwood G#9 Well No.
Office Address Wichita, Kansas 67202
Character of Well (completed as Oil, Gas or Dry Hole)
Date well completed 19
Application for plugging filed 19
Application for plugging approved 19
Plugging commenced 11/1/69 19
Plugging completed 11/7/69 19
Reason for abandonment of well or producing formation depleted.

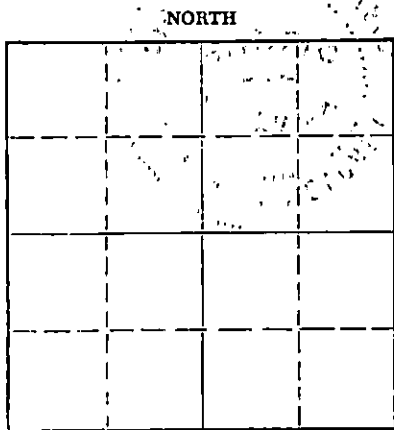

Locate well correctly on above Section Plat

If a producing well is abandoned, date of last production 19
Was permission obtained from the Conservation Division or its agents before plugging was commenced? yes

Name of Conservation Agent who supervised plugging of this well Warren
Producing formation Depth to top Bottom Total Depth of Well 4465' Feet
Show depth and thickness of all water, oil and gas formations.

OIL, GAS OR WATER RECORDS

CASING RECORD

FORMATION	CONTENT	FROM	TO	SIZE	PUT IN	PULLED OUT
				9"	324'	none
				5 1/2"	4435'	2477'

Describe in detail the manner in which the well was plugged, indicating where the mud fluid was placed and the method or methods used in introducing it into the hole. If cement or other plugs were used, state the character of same and depth placed, from feet to feet for each plug set.

Checked hole to 4485', pushed plug to 4350' and ran sand and 5 sacks of cement. Shot pipe at 3227', 3138', pumped 40 barrels of oil and 80 barrels of water. Shot pipe at 3017', 2803', 2625', 2511', pulled 79 joints. Bailed hole to 250', set 10' rock bridge, ran 25 sacks of cement. Mudded hole to 40', set 10' rock bridge and ran 10 sacks of cement. Tallied pipe.

PLUGGING COMPLETE.


RECEIVED
STATE CORPORATION COMMISSION
NOV 13 1969
CONSERVATION DIVISION
Wichita, Kansas

(If additional description is necessary, use BACK of this sheet)
Name of Plugging Contractor KNIGHT CASING PULLING CO., INC.
Address CHASE, KANSAS

STATE OF KANSAS COUNTY OF RICE, ss.
NOEL J. KNIGHT (employee of owner) or (owner or operator) of the above-described well, being first duly sworn on oath, says: That I have knowledge of the facts, statements, and matters herein contained and the log of the above-described well as filed and that the same are true and correct. So help me God.

(Signature) Noel J. Knight
CHASE, KANSAS (Address)

SUBSCRIBED AND SWORN TO before me this 10th day of November, 1969

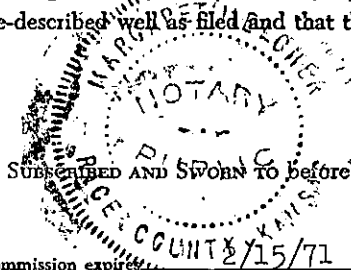

Margaret Melcher
Notary Public.

My commission expires 2/15/71

