


WELL PLUGGING RECORD

Give All Information Completely
Make Required Affidavit
Mail or Deliver Report to:
Conservation Division
State Corporation Commission
211 No. Broadway
Wichita, Kansas

NORTH

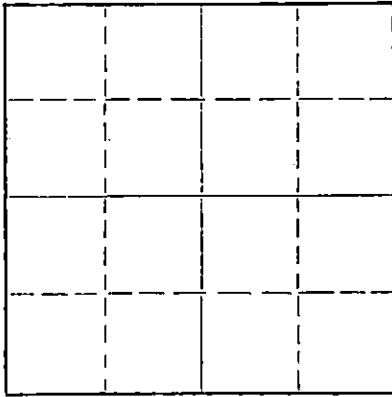

Locate well correctly on above
Section Plat

Seward County. Sec. 5 Twp. 35S Rge. (E)32 (W)
Location as "NE/CNW&SW" or footage from lines C NE SW
Lease Owner Graham-Michaelis Drilling Company
Lease Name PINEGAR Well No. 1
Office Address 211 North Broadway Wichita 2, Kansas
Character of Well (completed as Oil, Gas or Dry Hole) Dry Hole
Date well completed August 30 19 58
Application for plugging filed August 29 19 58
Application for plugging approved August 29 19 58
Plugging commenced August 30 19 58
Plugging completed August 30 19 58
Reason for abandonment of well or producing formation Dry Hole

If a producing well is abandoned, date of last production N/A 19
Was permission obtained from the Conservation Division or its agents before plugging was commenced? Yes

Name of Conservation Agent who supervised plugging of this well Don Peterson Box 52 Lakin, Kansas
Producing formation Depth to top Bottom Total Depth of Well Feet
Show depth and thickness of all water, oil and gas formations.

OIL, GAS OR WATER RECORDS

CASING RECORD

FORMATION	CONTENT	FROM	TO	SIZE	PUT IN	PULLED OUT
Red Bed	-	759	1605	8-5/8"	1543'	

Describe in detail the manner in which the well was plugged, indicating where the mud fluid was placed and the method or methods used in introducing it into the hole. If cement or other plugs were used, state the character of same and depth placed, from feet to feet for each plug set.

Filled hole w/rotary mud to 570', plug & 1/2 sx hull & 20 sx cement.
Top plug @35' w/1/2 sx hull & 10 sx cement

RECEIVED
STATE CORPORATION COMMISSION

SEP 11 1958

CONSERVATION DIVISION
Wichita, Kansas

(If additional description is necessary, use BACK of this sheet)

Name of Plugging Contractor Graham-Michaelis Drilling Company
Address 211 North Broadway Wichita 2, Kansas

STATE OF KANSAS, COUNTY OF SEDGWICK, ss.
O. W. Woodland (employee of owner) ~~owner or operator~~ of the above-described well, being first duly sworn on oath, says: That I have knowledge of the facts, statements, and matters herein contained and the log of the above-described well as filed and that the same are true and correct. So help me God.

(Signature) O. W. Woodland
211 North Broadway, Wichita 2, Kansas
(Address)

SUBSCRIBED AND SWORN to before me this 10th day of September, 19 58

E. Gene Byrd
Notary Public.

My commission expires Dec. 14, 1961

PLUGGING
FILE SEC 4 T. 35 R. 32W
BOOK PAGE 120 LINE 3

PINEGAR #1

15-175-10167-00-00

WELL RECORD

LOCATION: C NE SW Sec. 4-T35S-R32W Commenced: 8-3-58
Seward County, Kansas Completed: 8-30-58
(Rotary)

OPERATOR: Graham-Michaelis Drilling Company
211 North Broadway
Wichita 2, Kansas

CONTRACTOR: Graham-Michaelis Drilling Company
211 North Broadway
Wichita 2, Kansas

CASING RECORD: 8-5/8" @1543' w/550 sx comm w/3% gel, 1% cc
100 sx comm w/2% cc

LOG

Surface Clay & Soil	0 - 415
Red Bed & Sand	415 - 759
Red Bed	759 - 1605
Sand, Shale & Lime	1605 - 1837
Shale, Sand & Anhy.	1837 - 2220
Shale & Lime	2220 - 5174
Lime	5174 - 5257
Lime & Shale	5257 - 5420
Lime	5420 - 5707
Lime & Shale	5707 - 6051
Shale & Sand	6051 - 6115
Lime & Shale	6115 - 6158
Shale	6158 - 6198
Lime & Shale	6198 - 6210

Rotary total depth - 6210

STATE OF KANSAS)
) ss.
COUNTY OF SEDGWICK)

RECEIVED
STATE CONSERVATION COMMISSION
FEB 18 1959
CONSERVATION DIVISION
Wichita, Kansas

The undersigned, GRAHAM-MICHAELIS DRILLING COMPANY, hereby certifies that the above log is a true and correct log of the formations encountered in the drilling of the above well as reflected by the Daily Drilling Report.

GRAHAM-MICHAELIS DRILLING COMPANY

By John L. France
Geologist

Sworn and subscribed to before me
this 23rd day of September, 1958

E. Gene Byrd
E. Gene Byrd Notary Public
My commission expires: Dec. 14, 1961

PLUGGING
FILE SEC. 4 T. 35 R. 32W
BOOK PAGE 128 LINE 3