

STATE OF KANSAS
STATE CORPORATION COMMISSION


WELL PLUGGING RECORD

15-025-20437-0000

Give All Information Completely
Make Required Affidavit
Mail or Deliver Report to
Conservation Division
State Corporation Comm.
245 North Water
Wichita, KS 67202

Clark County, Sec. 21 Twp. 31S Rge. 21WE/W
Location as "NE/CNW $\frac{1}{4}$ SW $\frac{1}{4}$ " or footage from lines
C NE NW

Lease Owner Beren Corporation
Lease Name Strodtman Well No. 1
Office Address 970 Fourth Financial Center, Wichita, KS 67202
Character of Well (Completed as Oil, Gas or Dry Hole)

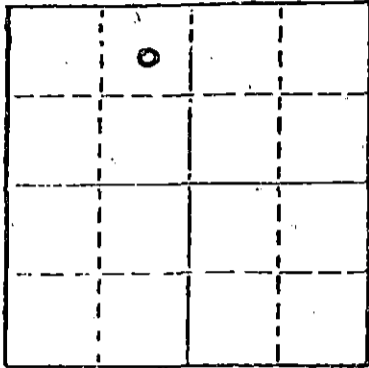

Locate well correctly on above
Section Plat

dry hole
Date Well completed January 30, 1981 19
Application for plugging filed January 29, 1981 19
Application for plugging approved January 29, 1981 19
Plugging commenced January 29, 1981 19
Plugging completed January 29, 1981 19
Reason for abandonment of well or producing formation
dry hole

If a producing well is abandoned, date of last production 19

Was permission obtained from the Conservation Division or
its agents before plugging was commenced? yes

Name of Conservation Agent who supervised plugging of this well Carl Barnett
Producing formation Depth to top Bottom Total Depth of Well

Show depth and thickness of all water, oil and gas formations.

OIL, GAS OR WATER RECORDS

CASING RECORD

FORMATION	CONTENT	FROM	TO	SIZE	PUT IN	PULLED OUT

Describe in detail the manner in which the well was plugged, indicating where the mud fluid
was placed and the method or methods used in introducing it into the hold. If cement or other
plugs were used, state the character of same and depth placed, from feet to
feet for each plug set.

Hole plugged with common as follows:
30 sacks @ 1120', 30 sacks @ 500', 10 sacks @ 40',
5 sacks rat hole, 5 sacks mouse hole by Howco.
Plugging completed 2:30 AM, January 30, 1981.

(If additional description is necessary, use BACK of this sheet)

Name of Plugging Contractor BEREDCO INC.

STATE OF Kansas COUNTY OF Sedgwick, ss.
J. D. Marcus (employee of owner) or (owner or operator)
of the above-described well, being first duly sworn on oath, says: That, I have knowledge of
the facts, statements, and matters herein contained and the log of the above-described well
as filed and that the same are true and correct. So help me God.

(Signature)

970 Fourth Financial Center, Wichita, KS 67202
(Address)

SUBSCRIBED AND SWORN TO before me this 10th day of March, 1981.



Notary Public.

My commission expires 4/27/81

RECEIVED
STATE CORPORATION COMMISSION

MAR 13 1981

CONSERVATION DIVISION
Wichita, Kansas

DRILLERS LOG

STRODTMAN #1

Clark County
C NE NW
Sec. 21-31S-21W

15-025 - 20437-0000

Company: BEREN CORPORATION

Contractor: BEREDCO INC.

Comm: January 18, 1981

Comp.: January 30, 1981

Casing: 8 5/8", 28# set at 1115' with 400 sacks Halcolite & 150 sacks common
3% CC.
dry hole

<u>FORMATION</u>	<u>FROM</u>	<u>TO</u>
RB	0'	1498'
RB & Shale	1498'	2020'
Lime & Shale	2020'	5205'
Lime	5205'	5320'

Rotary Total Depth - 5320'


STATE OF KANSAS

SS:

COUNTY OF SEDGWICK

I certify that this is a true and correct copy of the above log as
shown by the drilling reports.

BEREDCO

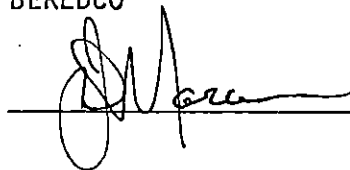

RECEIVED
STATE CORPORATION COMMISSION

MAR 13 1981

CONSERVATION DIVISION
Wichita, Kansas

Subscribed and sworn to before me this 10th day of March, 1981.



