

15-025-20661-00-00


STATE OF KANSAS
STATE CORPORATION COMMISSION

WELL PLUGGING RECORD

Give All Information Completely
Make Required Affidavit
Mail or Deliver Report to
Conservation Division
State Corporation Comm.
245 North Water
Wichita, KS 67202

Clark County, Sec. 21 Twp. 31S Rge. 21WE/W
Location as "NE/CNW $\frac{1}{4}$ SW $\frac{1}{4}$ " or footage from lines
SW NW

Lease Owner Beren Corporation
Lease Name Strodtman Well No. 2
Office Address 970 4th Fin. Ctr, Wichita, Kansas 67202
Character of Well (Completed as Oil, Gas or Dry Hole) Dry Hole

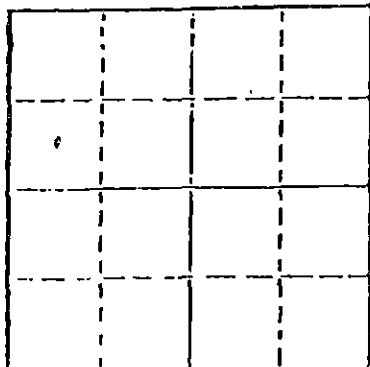

Locate well correctly on above
Section Plot

Date Well completed February 5, 19 83
Application for plugging filed February 5, 19 83
Application for plugging approved February 5, 19 83
Plugging commenced February 5, 19 83
Plugging completed February 5, 19 83
Reason for abandonment of well or producing formation Dry Hole

If a producing well is abandoned, date of last production 19

Was permission obtained from the Conservation Division or
its agents before plugging was commenced? yes

Name of Conservation Agent who supervised plugging of this well Steve Durant
Producing formation _____ Depth to top _____ Bottom _____ Total Depth of Well _____
Show depth and thickness of all water, oil and gas formations.

OIL, GAS OR WATER RECORDS

CASING RECORD

FORMATION	CONTENT	FROM	TO	SIZE	PUT IN	PULLED OUT

Describe in detail the manner in which the well was plugged, indicating where the mud fluid was placed and the method or methods used in introducing it into the hold. If cement or other plugs were used, state the character of same and depth placed, from _____ feet to _____ feet for each plug set.

Plugged w/ 50 sks @ 1230'
40 sks @ 540'
10 sks @ 40-0'
10 sks Mouse hole
10 sks Rat hole

Cement 50-50 Pozmix 4% Gel, 2% CC

(If additional description is necessary, use BACK of this sheet)

Name of Plugging Contractor Halliburton


STATE OF Kansas COUNTY OF Sedgwick, ss.
Jerome D. Marcus (employee of owner) or (owner or operator)
of the above-described well, being first duly sworn on oath, says: That I have knowledge of the facts, statements, and matters herein contained and the log of the above-described well as filed and that the same are true and correct. So help me God.

(Signature) [Signature]
401 E. Douglas, Suite #402, Wichita, Kansas 6720
(Address)

SUBSCRIBED AND SWORN TO before me this 9th day of February, 19 83

Cheryl L. Benoit
Notary Public.

My commission expires June 8, 1985

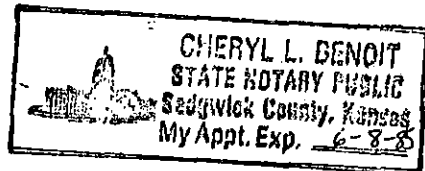

FEB 14 1983

CONSERVATION DIVISION
Wichita, Kansas